


T.25S.,R.14E.,W.M.

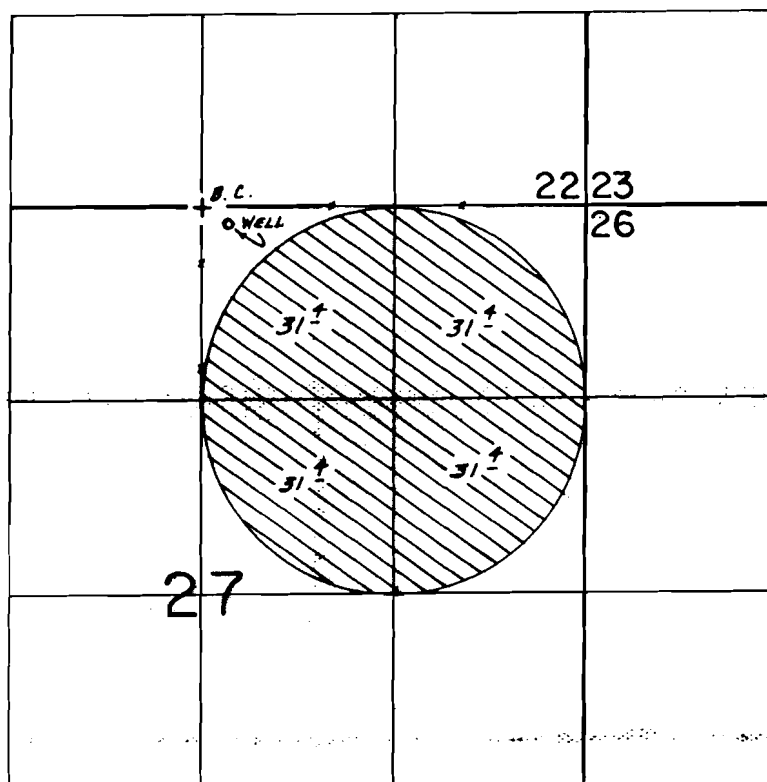

WELL LOC.: 110'S. & 190'E. FROM N 1/4 COR. SEC. 27.

SCALE: 1" = 1320'

FINAL PROOF SURVEY **UNDER**

Application No. G:10925. Permit No. G:10122.....
IN NAME OF

.....DAVE PICK.....

Surveyed June 7..... 1988, by R.W. BISHOP.....