


T.14S., R.12E., W.M.

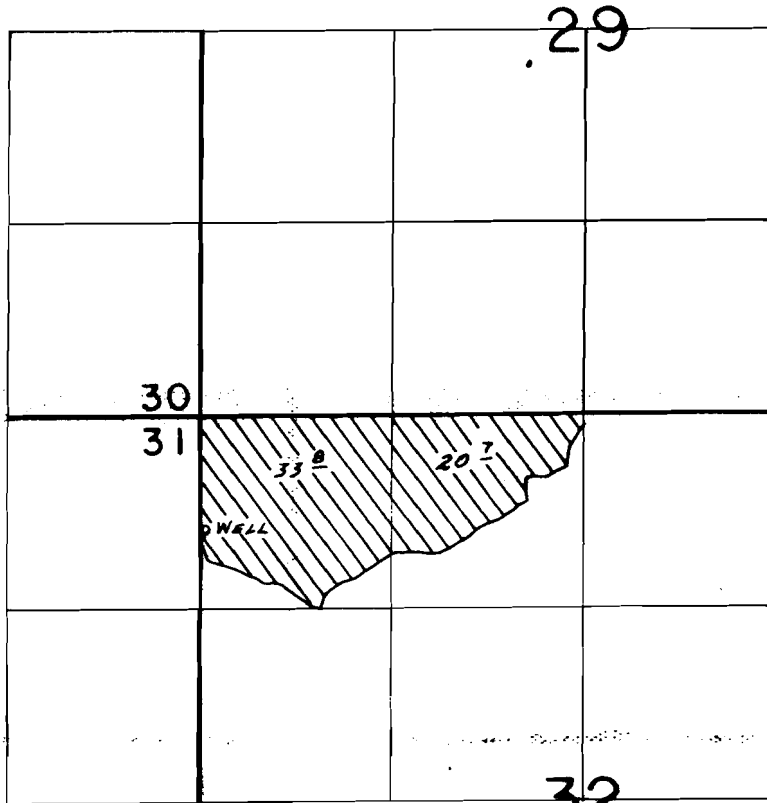

WELL LOC.: 780'S. & 40'E. FROM NW COR. SEC. 32.

SCALE: 1" = 1320'

## FINAL PROOF SURVEY UNDER

Application No. G-11027 Permit No. G-10193...  
IN NAME OF

ALBERT L. & MONA R. MITCHELL

Surveyed Apr. 27, 1988, by B.W. BISHOP

cert. #64132

RECEIVED

DATE 3-28-90

WATER MASTER DISTRICT #11

BY *gms*

11/16/00  
PTS 11-1988 *gms*

G10193