
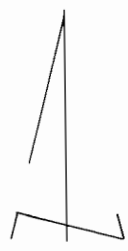


T. 18 S., R. 45 E., W. M.

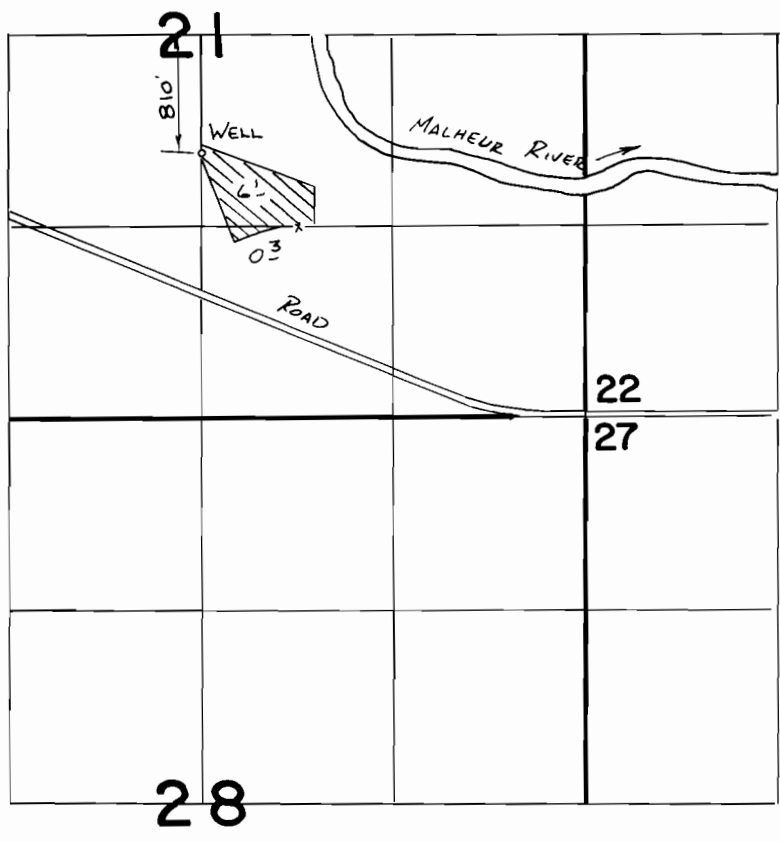

SCALE 1" = 1320'

FINAL PROOF SURVEY
UNDER

Application No. **G:11063** Permit No. **G:10300**
IN NAME OF

JAMES C. & LINDA L. SMITH

Surveyed *5-23* 1988, by *V.L. Church*