


T. 35 S., R. 2 W., W. M.

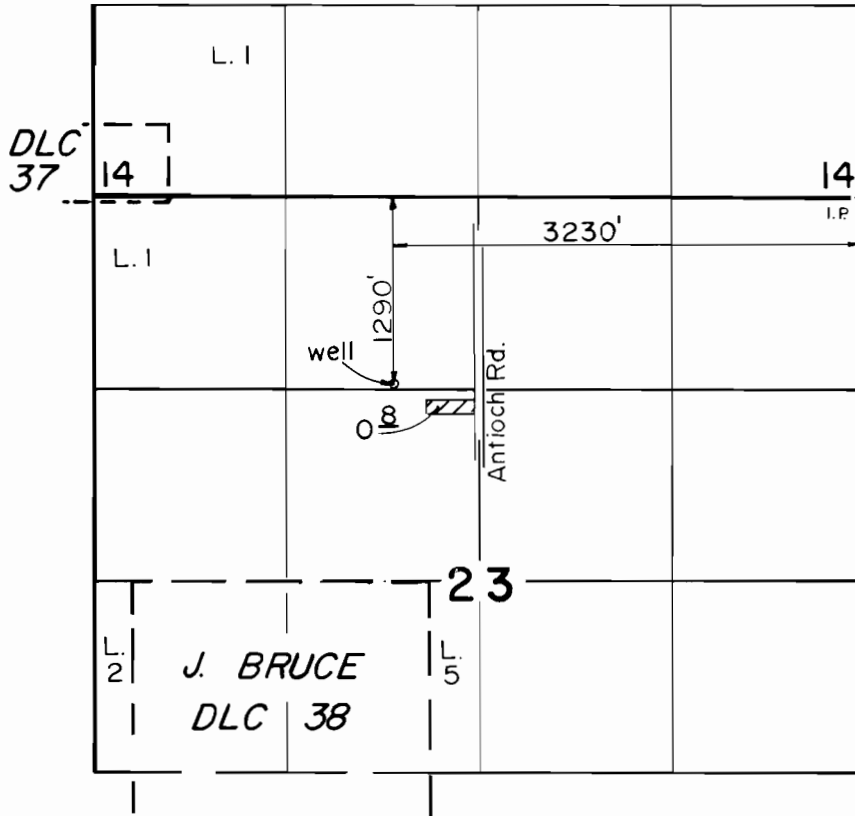

Scale: 1" = 1320'

**FINAL PROOF SURVEY**  
UNDER

Application No. ~~G-11074~~ Permit No. ~~G-10229~~  
IN NAME OF

G. B. ELTON

Surveyed MAR 31 1988, by B. S. JAMES