


T. 24S., R. 30E., W.M.

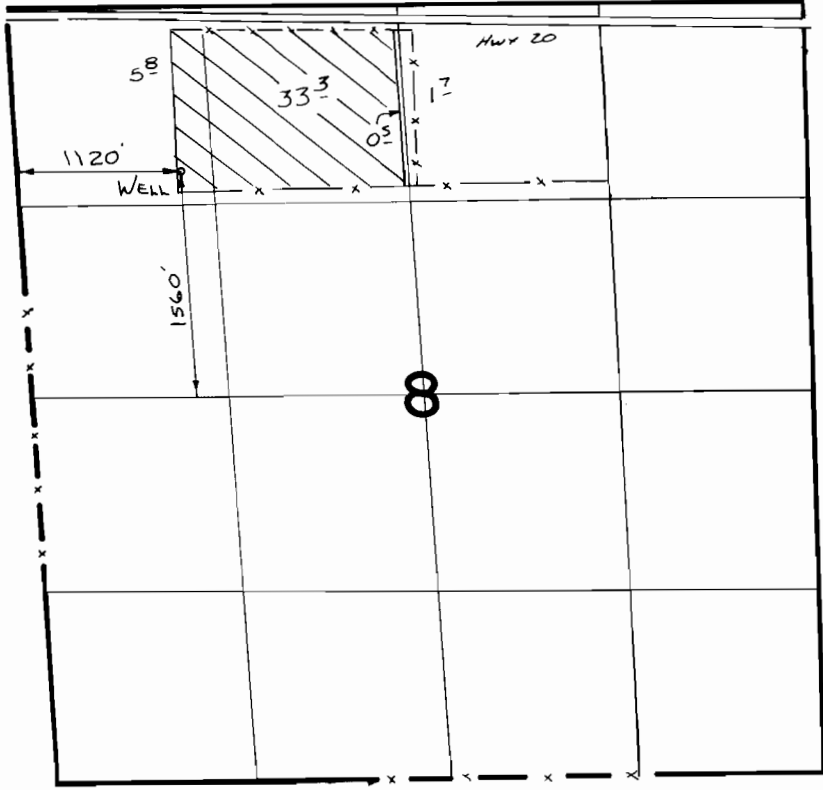

SCALE 1" = 1320'

FINAL PROOF SURVEY
UNDER

Application No. **G:11173** Permit No. **G:10383**
IN NAME OF

HAROLD WOODRUFF

Surveyed 5-7 1988, by B.S. James