


T.15S., R.13E., W.M.

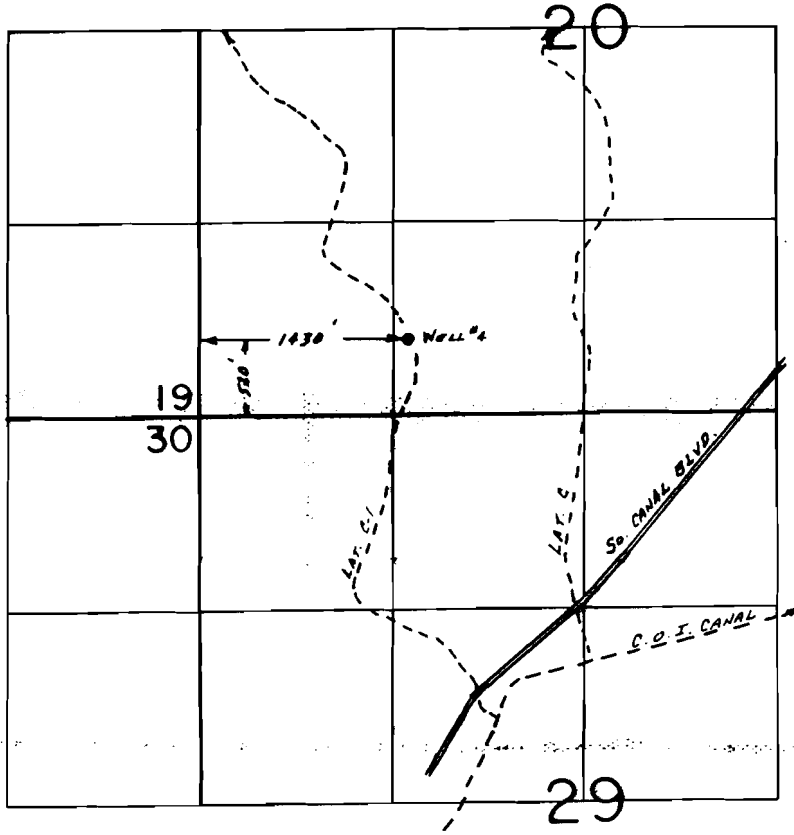

SCALE: 1" = 1320'

**FINAL PROOF SURVEY**  
UNDER

Application No. G-11439; Permit No. G-10544  
IN NAME OF

*cert. 64139*

CITY OF REDMOND

Surveyed June 22, 1988, by B.W. BISHOP

RECEIVED

DATE 3-28-90

WATER MASTER DISTRICT #11

BY *ems*

*11/20/88*

*41017-179-10544 INS.*

*G 10544*