




T.27S.,R.14W.,W.M.

SECTION 17

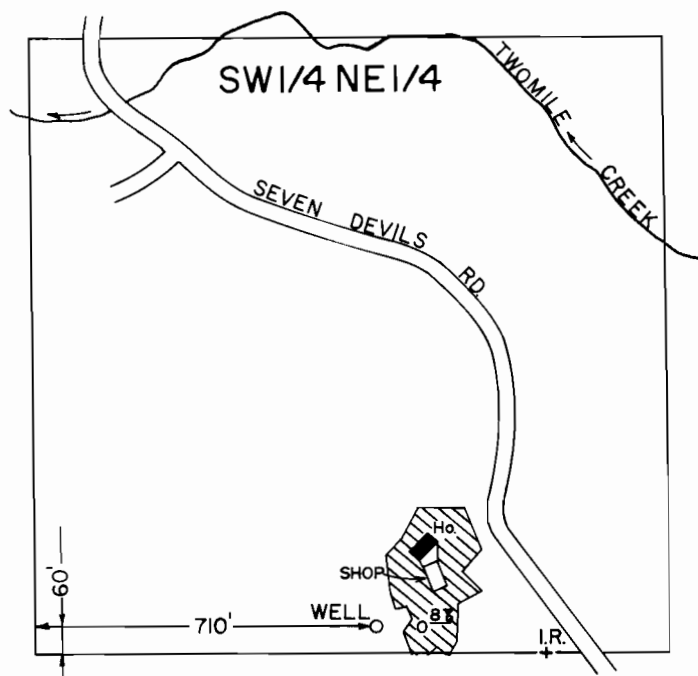

SCALE: 1" = 400'

FINAL PROOF SURVEY
UNDER

Application No. G-11506 Permit No. G-10618
IN NAME OF

NOEL KATHERINE ERTEL

Surveyed SEPT. 18, 1988, by L. H. NUNN