


T2S, R4E, WM

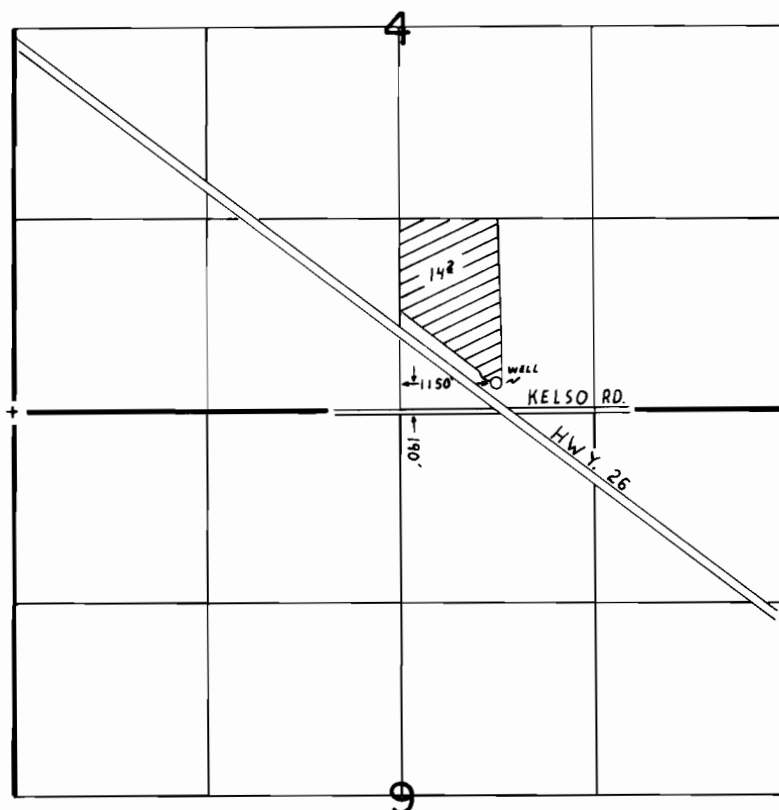

1" = 1320'

FINAL PROOF SURVEY UNDER

Application No. G-11565 Permit No. G-10648..
IN NAME OF

HARRY G. & FLORENCE CHATELAIN

Surveyed JULY 28, 1987, by T.M. WARREN..