T. 7S., R. 39 & 40E., W.M.

FINAL PROOF SURVEY

UNDER

APPL. 53061 PERMIT 42470
54641 42472
61406 46561

TRAN. 4706 (SP. OR. V. P.)
4707 (SP. OR. V. P.)

IN NAME OF

FARM CREDIT BANK OF SPOKANE

SURVEYED 7-15-82, 11-16-87 BY V.L.CHURCH

T-4707 POWDER R. ONLY

T-4706 POWDER R. ONLY

PER. 42472 POWDER R. & UNNAMED SLOUGH

PER. 42470 UNNAMED SLOUGH ONLY

PER. 46561
- SUPP'L SLOUGH ONLY
- PRIM POWDER R. SUPP'L SLOUGH
- POWDER R. ONLY

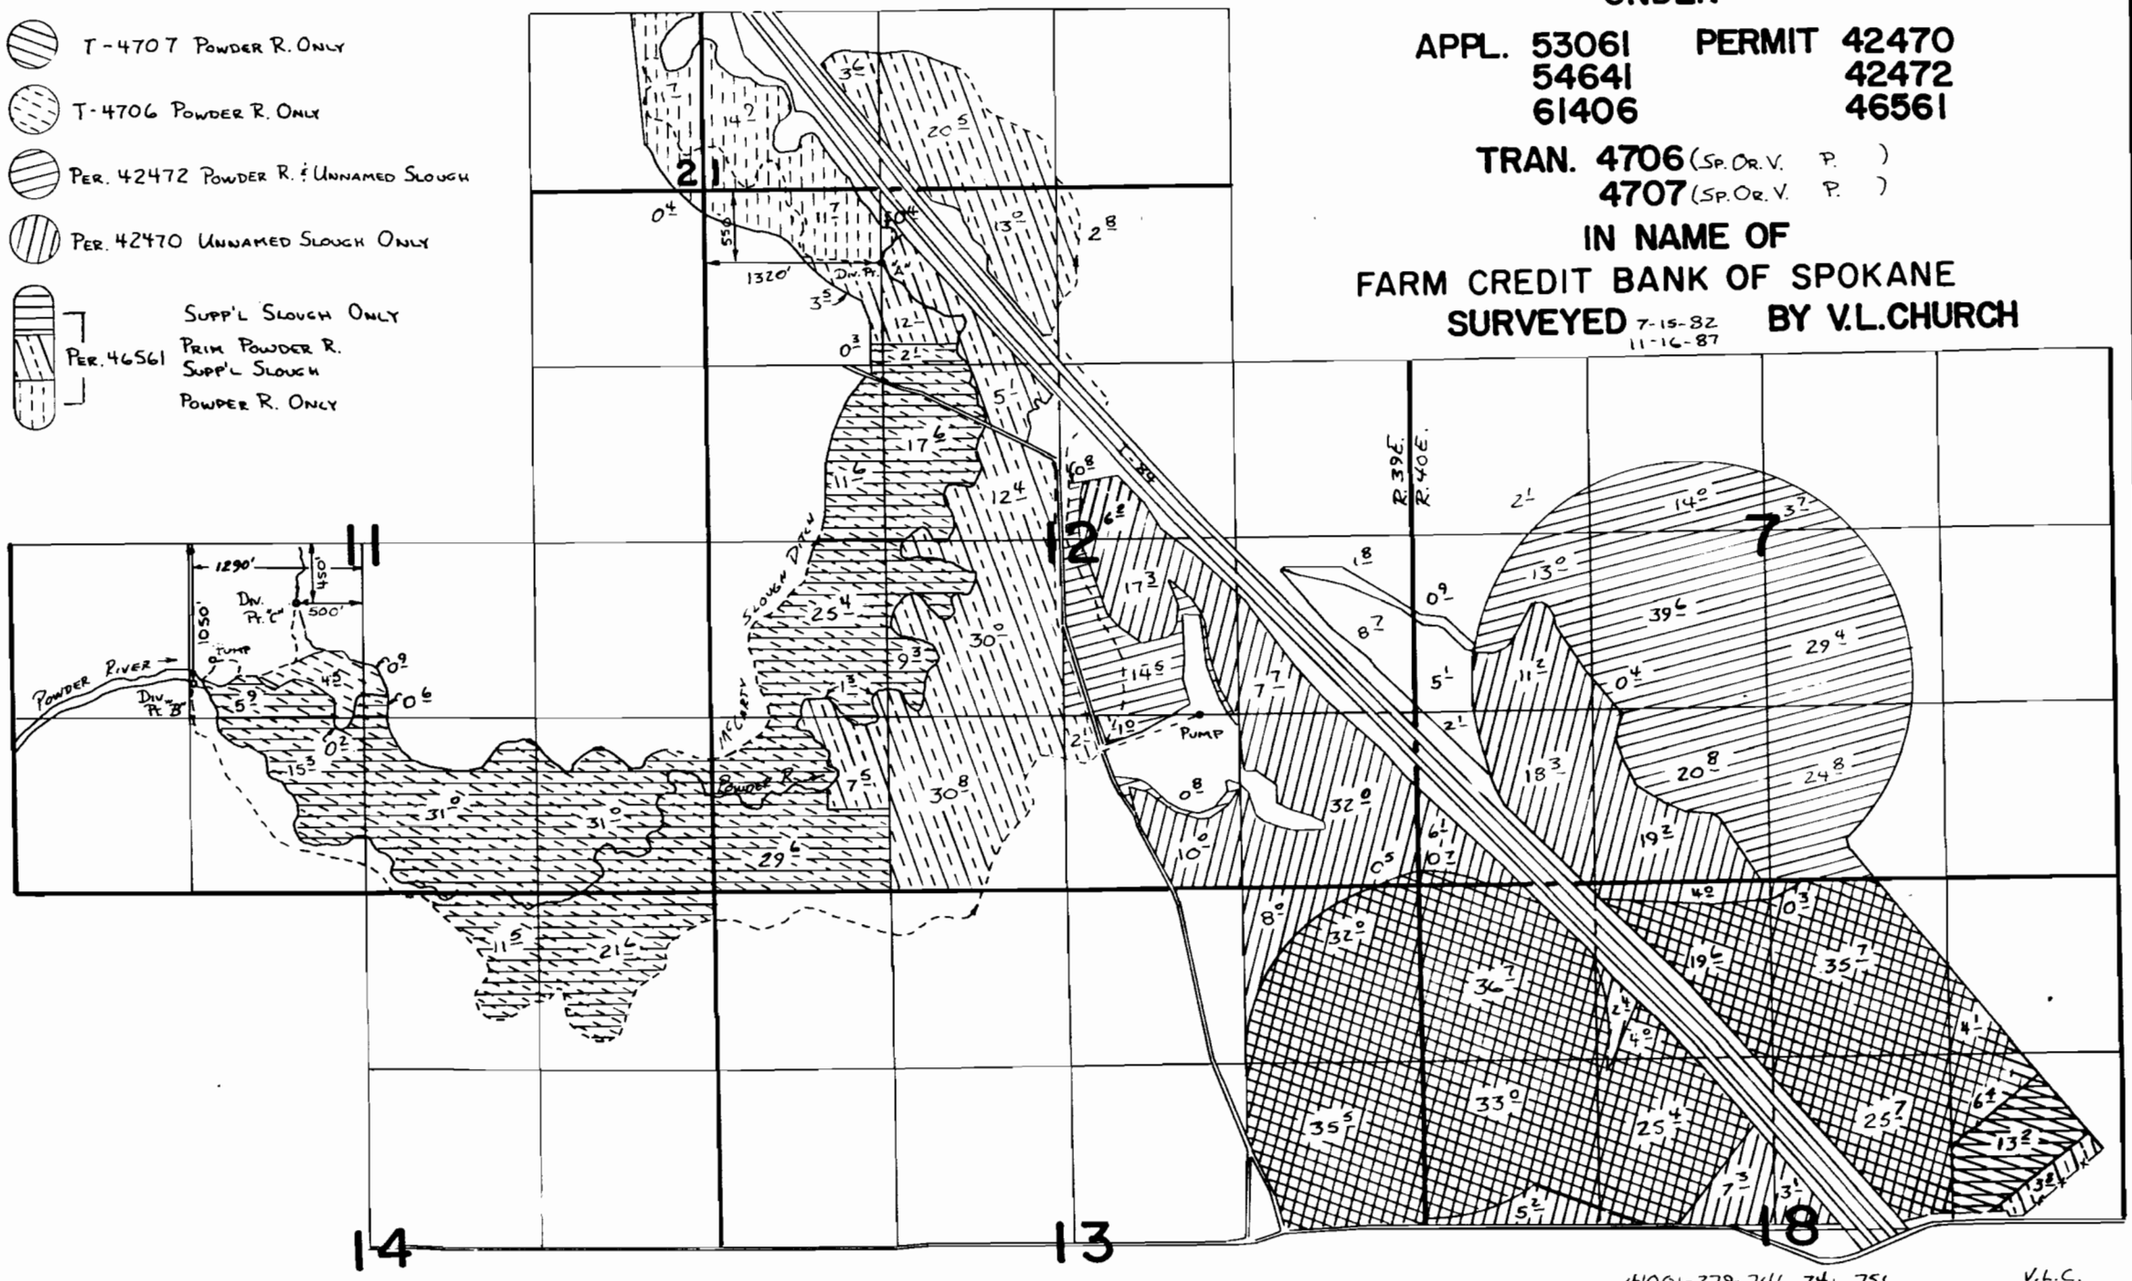

41001-279-74L, 74L, 75L

V.L.C.