








T. 7S., R. 39 & 40E., W.M.


FINAL PROOF SURVEY
UNDER

APPL. 53061 PERMIT 42470
54641 42472
61406 46561

TRAN. 4706 (SP. OR. V. P.)
4707 (SP. OR. V. P.)

IN NAME OF
FARM CREDIT BANK OF SPOKANE
SURVEYED 7-15-82 BY V.L. CHURCH
11-16-87

-  T-4707 POWDER R. ONLY
-  T-4706 POWDER R. ONLY
-  PER. 42472 POWDER R. & UNNAMED SLOUGH
-  PER. 42470 UNNAMED SLOUGH ONLY
-  SUPP'L SLOUGH ONLY
-  PER. 46561 PRIM POWDER R.
SUPP'L SLOUGH
-  POWDER R. ONLY

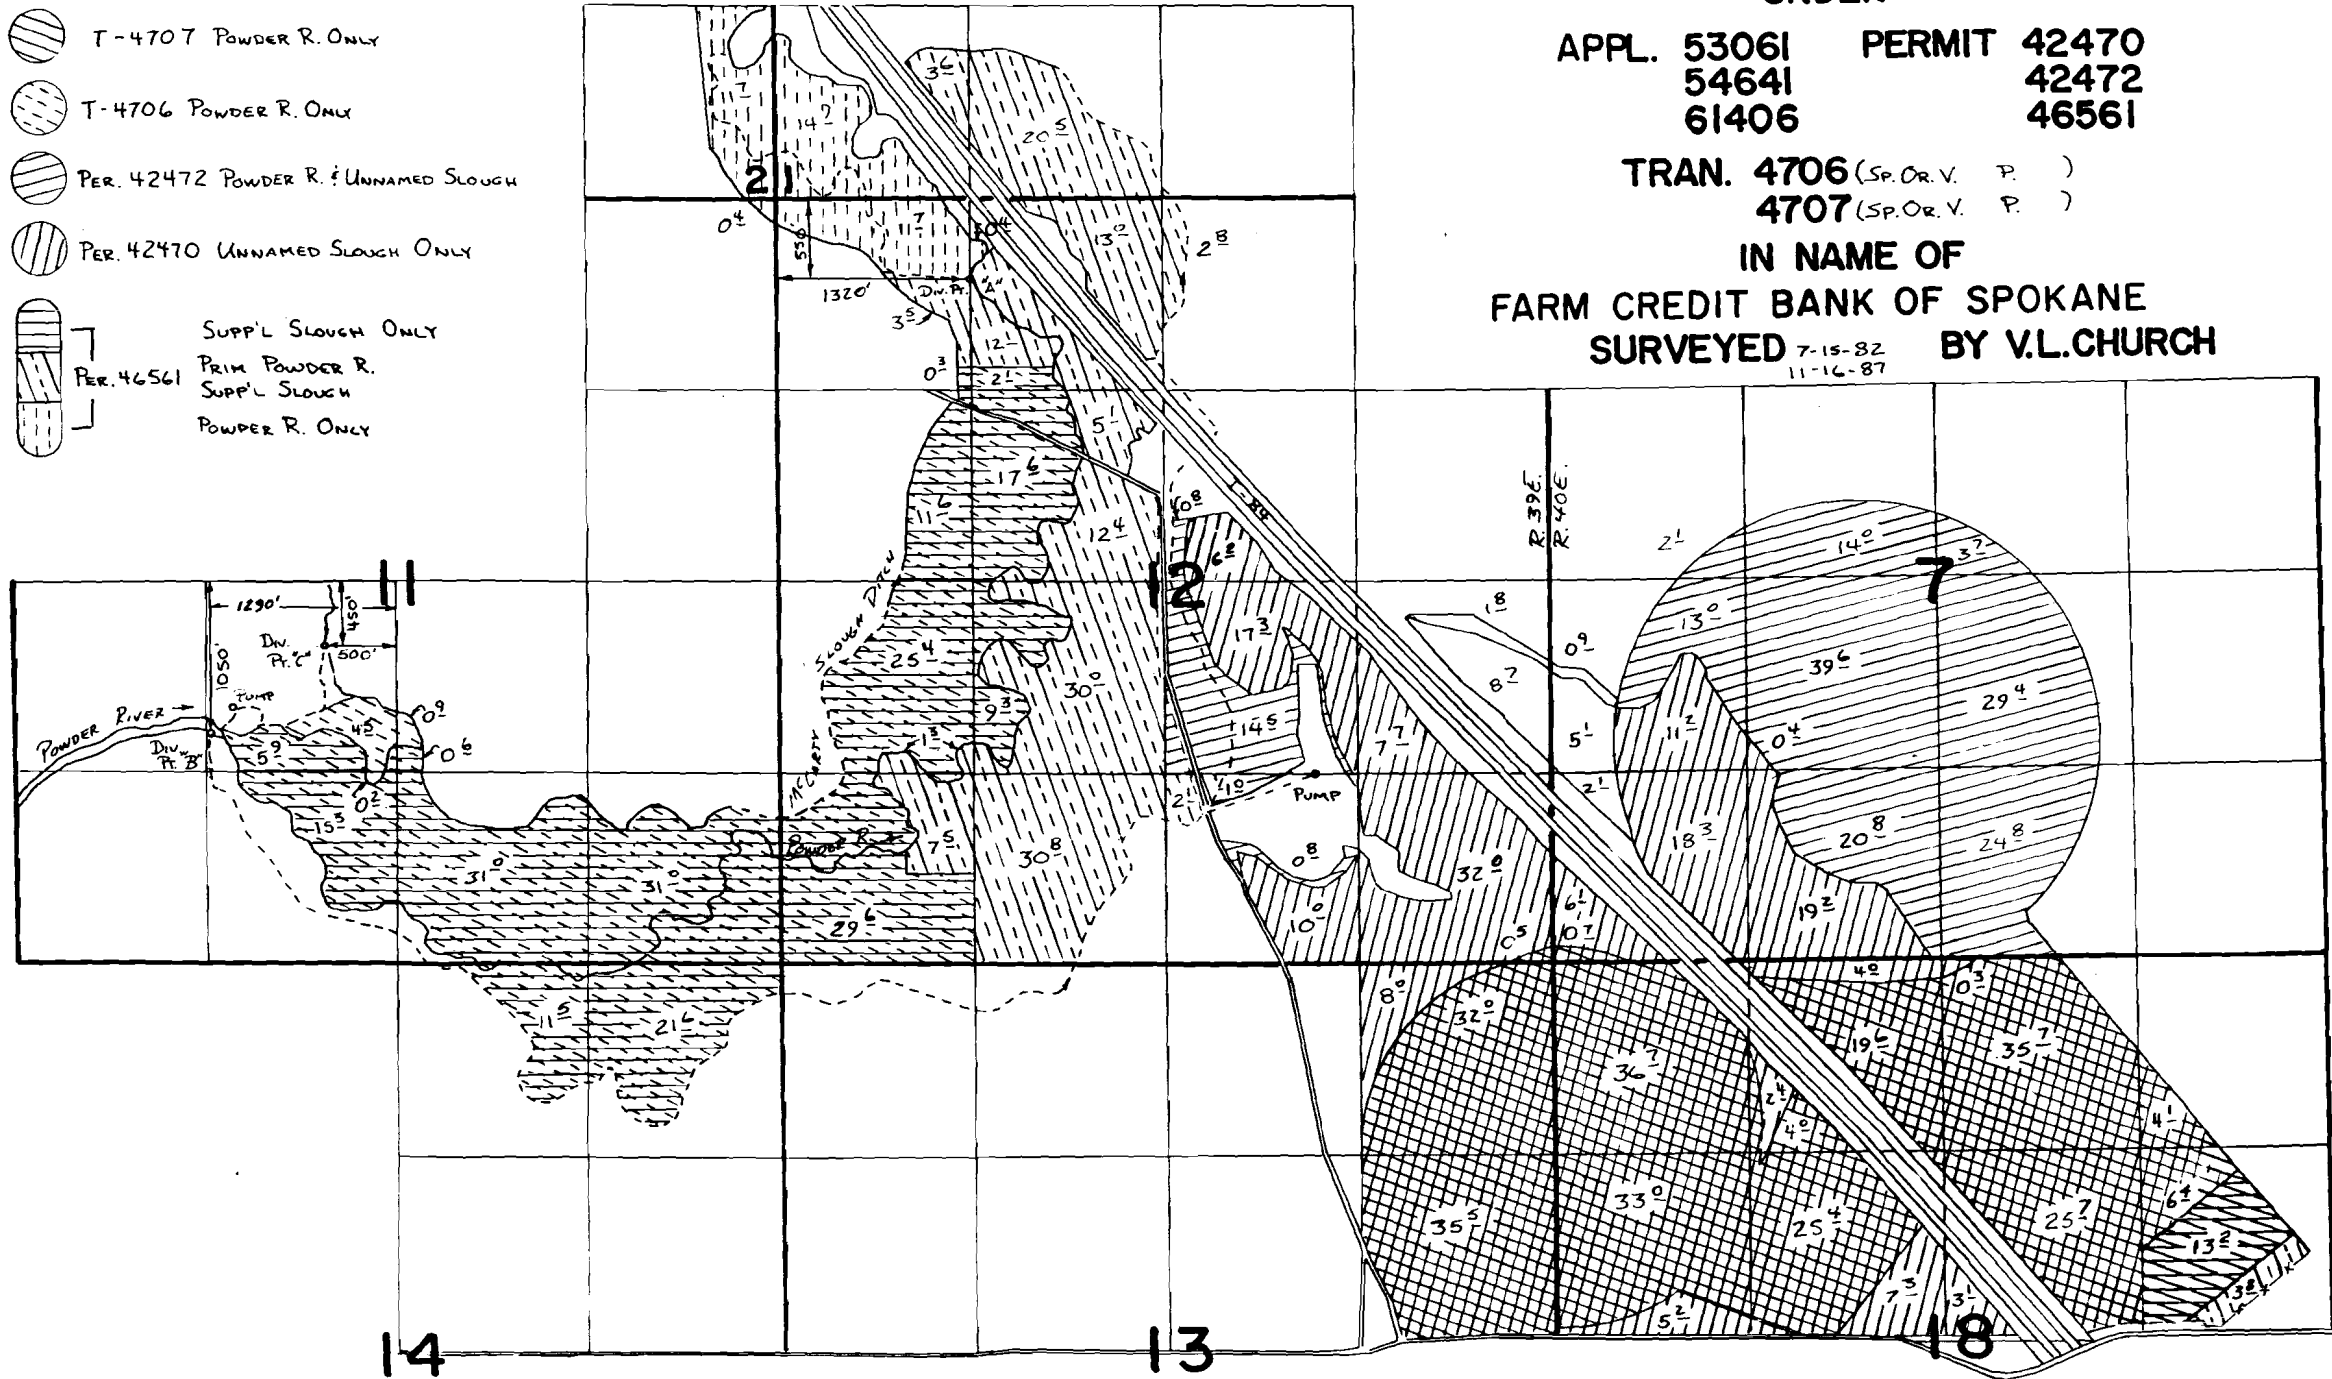

14

13

18