



T. 40 S., R. 14 W., W.M.

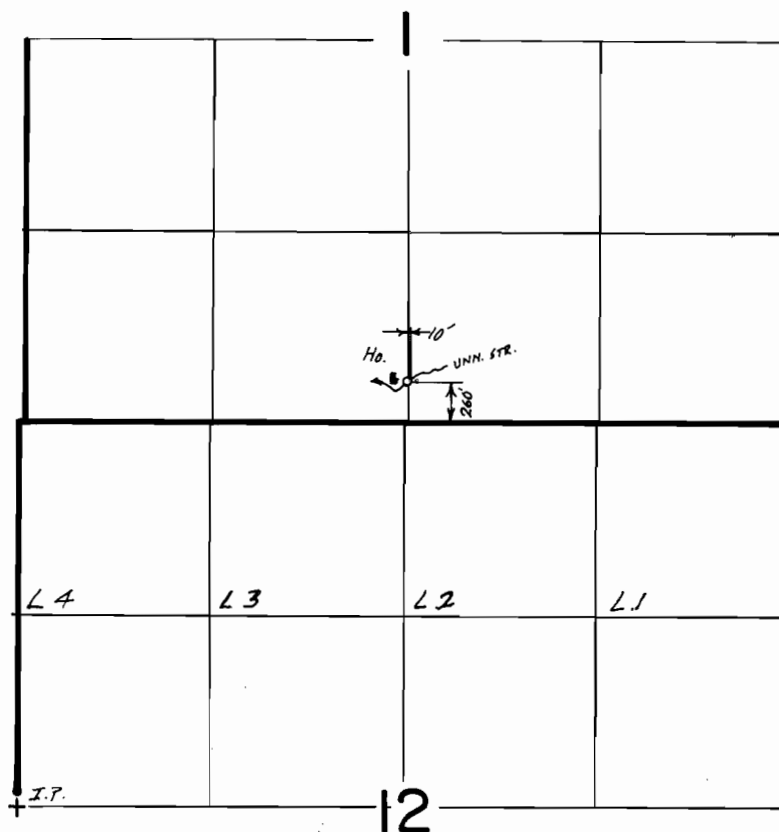

Scale 1"=1320'

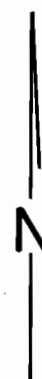

FINAL PROOF SURVEY
UNDER

Application No. 54180.. Permit No. 40611.....
IN NAME OF

.....JOHN A. MINOR.....

Surveyed Sept. 3... 1987, by J.M. SCHMORDE