




T. 22 S., R. 7 W., W. M.

SECTION 32

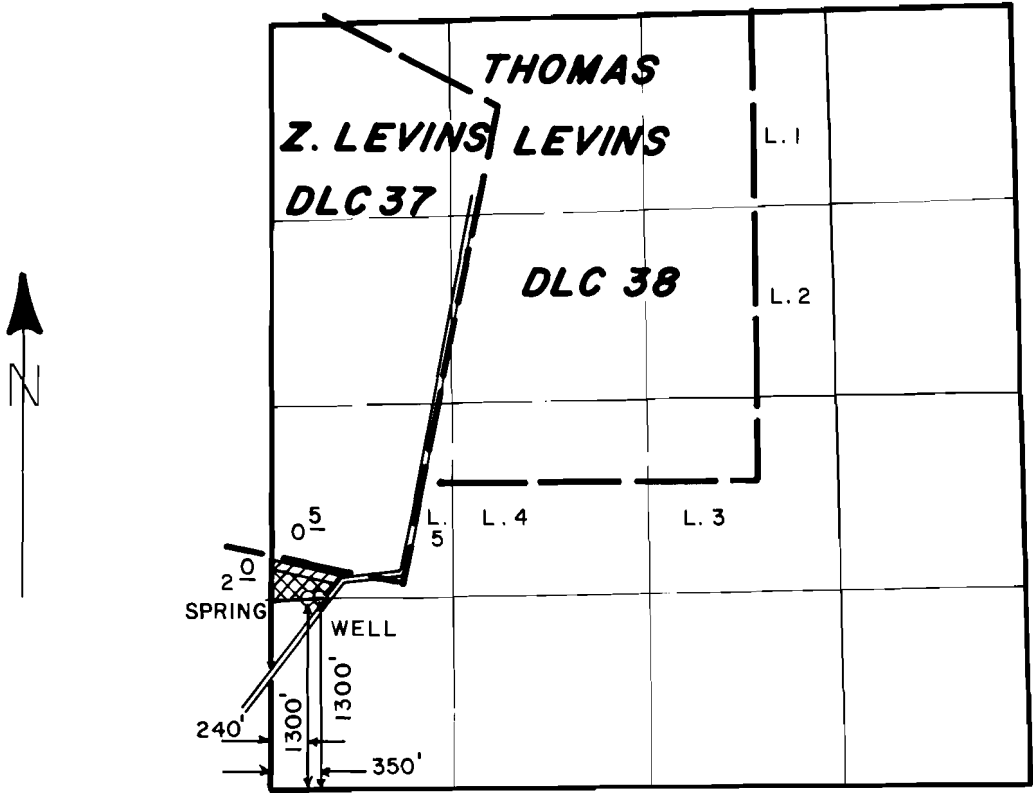

 PRIMARY
 SUPPLEMENTAL

SCALE: 4" = 1 MILE

FINAL PROOF SURVEY UNDER

Application No. 55683 G-10391 Permit No. 41713 G-9597
 IN NAME OF

REX E. AND LILLY C. POTTER

Surveyed AUG 27. 1987. by J. M. SCHMORDE