



43460
64153

T.38S, R.8E., W.M.

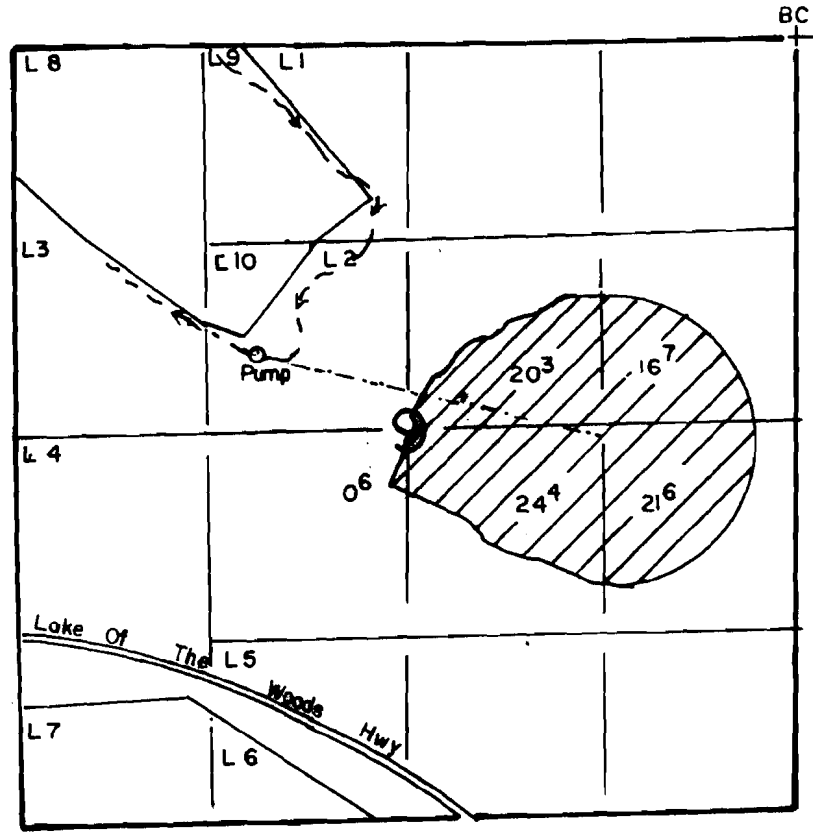

T37S,R8E,W/M

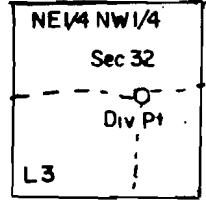

Div Pt Loc 640'S & 400'W From
The N 1/4 Cor Of Sec 32

SCALE: 1"=1320'

FINAL PROOF SURVEY UNDER

Application No. 57676..... Permit No. 43460.....
IN NAME OF

..... D. D. LAND CO.

Surveyed JUNE 15, 1989, by B.W. BISHOP.....

Notes to Sec. & Misc.