


T6N, R6W, WM

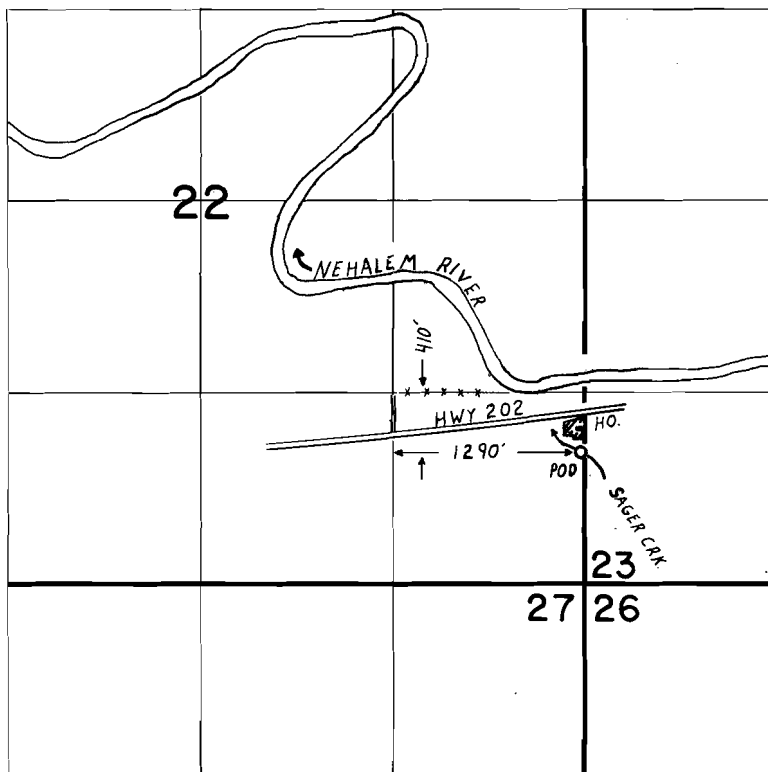

1" = 1320'

FINAL PROOF SURVEY UNDER

Application No. 58095 Permit No. 43757.....
IN NAME OF

.....HOWARD A. JOHNSON.....

Surveyed AUG. 17... 1988, by J.M. WARREN.....