


T.9S., R.14E., W. M.

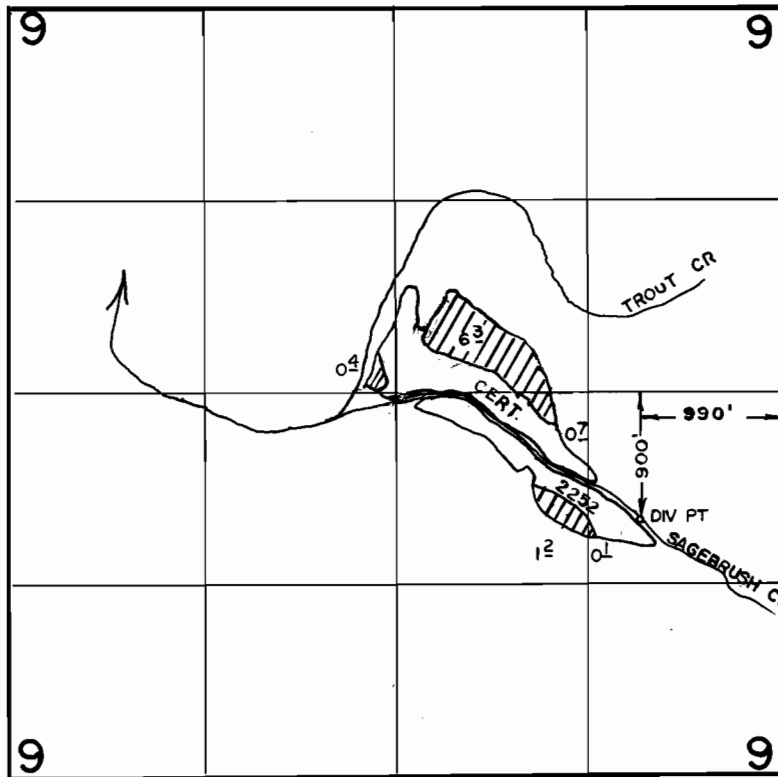

SCALE: 1" = 1320'

FINAL PROOF SURVEY
UNDER

Application No. 58709... Permit No. 44271.....
IN NAME OF

.....**ESTATE OF JOSEPH B. OTTER**.....

Surveyed OCT. 3..... 1989., by B.W. BISHOP.....