


T. 31 S., R. 1 W., W. M.

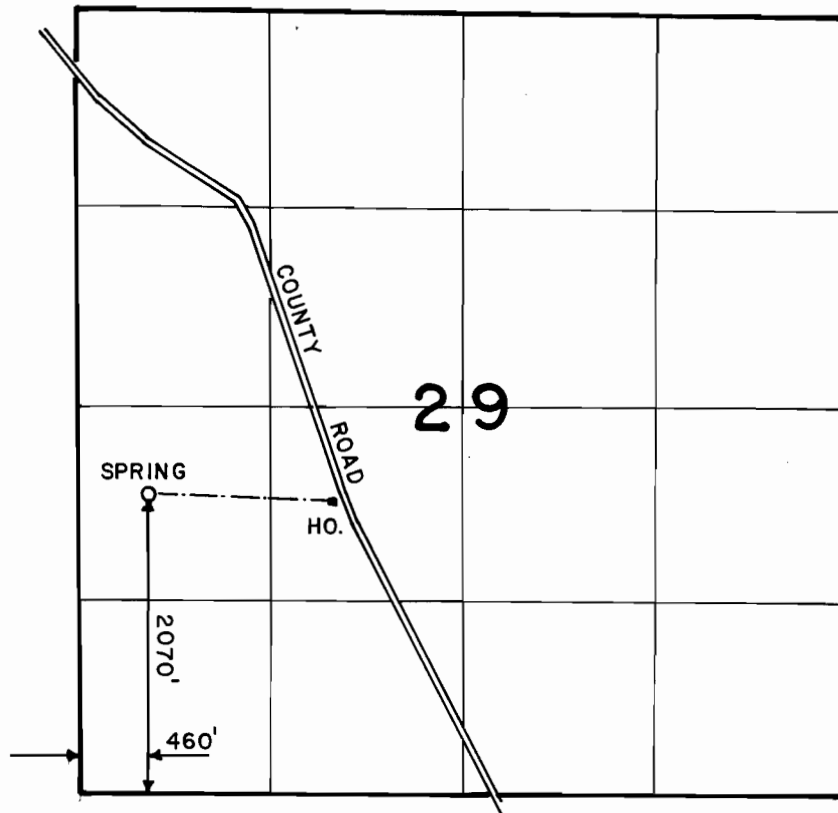

SCALE: 4" = 1 MILE

FINAL PROOF SURVEY
UNDER

Application No. 59279... Permit No. 44696.....
IN NAME OF

ALBERT L. GROVES

Surveyed APRIL 6, 1988, by J.M. SCHMORDE.