




T. 31 S., R. 15 W., W.M.

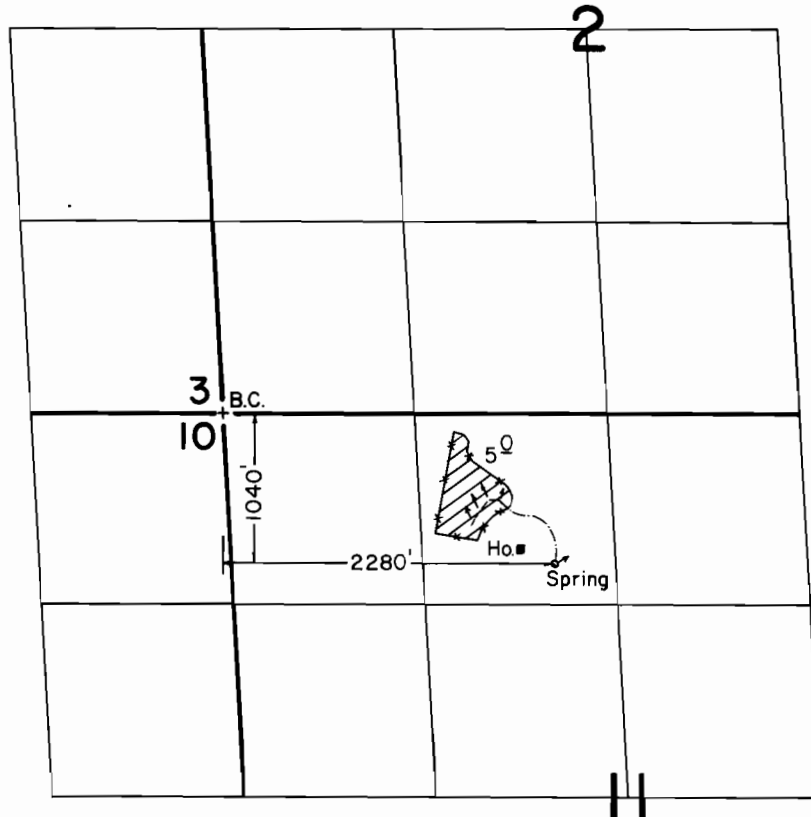

SCALE: 1" = 1320'

FINAL PROOF SURVEY
UNDER

Application No. 61045 Permit No. 45497
IN NAME OF

HARVEY C. OLSON

Surveyed JUNE 24 1988, by B. S. JAMES