


T. 13S., R. 26E., W. M.

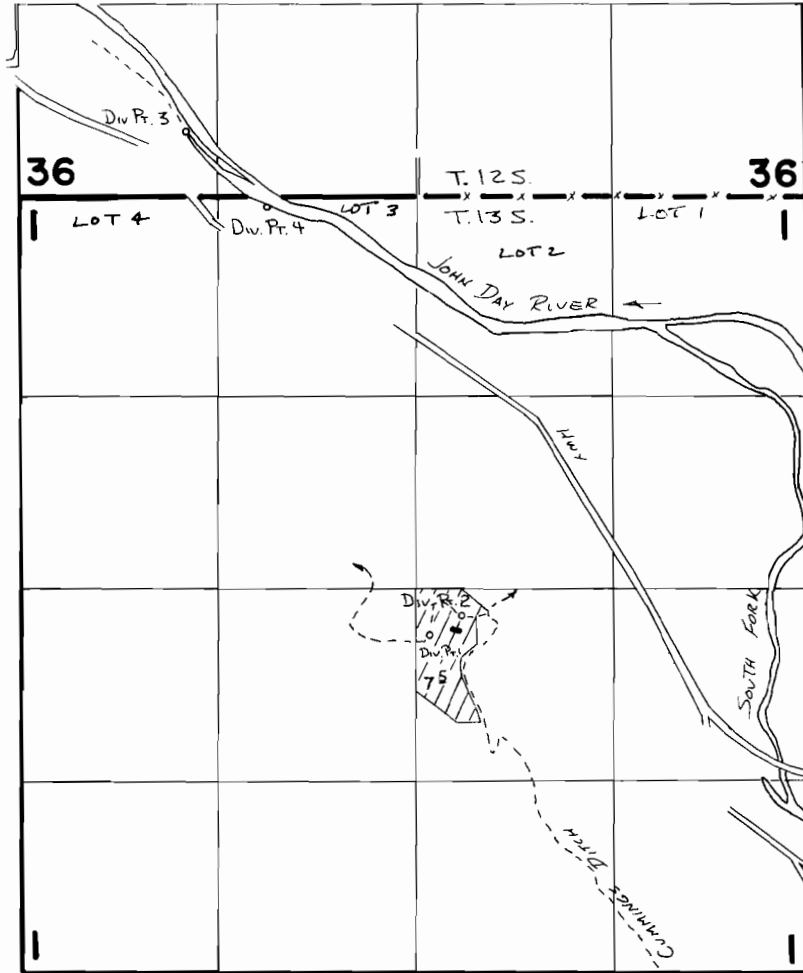

Div. Pt. 1 Loc: 320'S. & 90'E. }  
Div. Pt. 2 Loc: 190'S. & 320'E. } FROM CENTER COR. SEC. 1  
T-3274 { Div. Pt. 3 Loc: 450'N. & 1580'W. }  
Div. Pt. 4 Loc: 60'S. & 1030'W. } FROM N<sup>1</sup>/<sub>4</sub> COR. SEC. 1.

**FINAL PROOF SURVEY**  
UNDER

**TRANSFER 3274**

Application No. **63541** Permit No. **46832**  
IN NAME OF

**JOHN E. FISHER II**

Surveyed ... 7-22 ... 1986, by V. A. Church