


T.29S., R.6W., W.M.

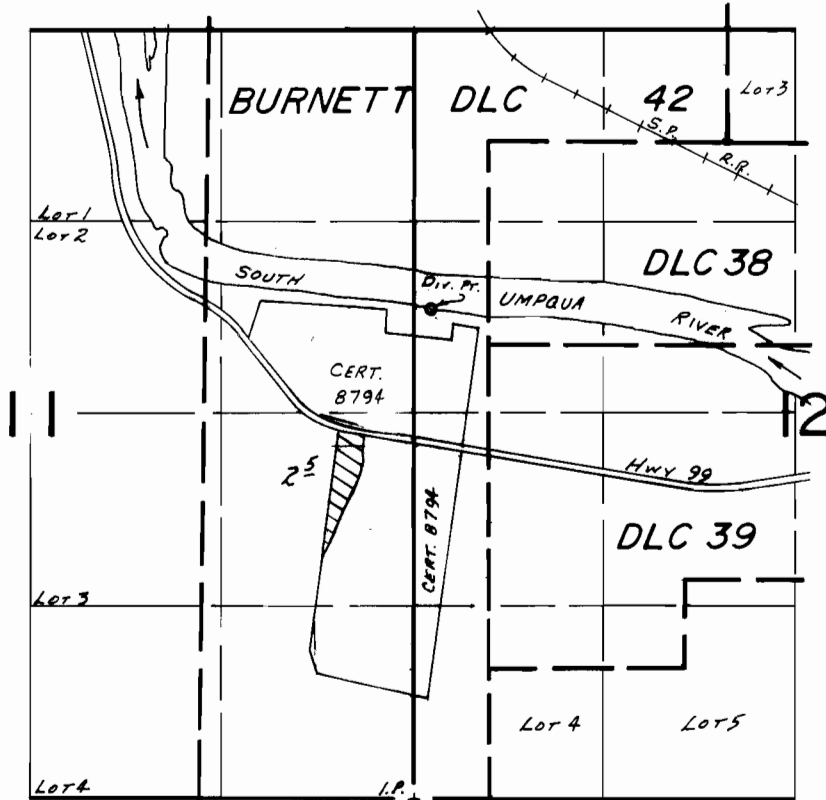

DIV. PT. LOC: 3560 N. & 110' E. FROM SW COR. SEC. 12.

FINAL PROOF SURVEY UNDER

Transfer No. 5062
Application No. 63579.. Permit No. 47080.....
IN NAME OF

.....WILLIAM F. GROSS.....

Surveyed DEC. 12..... 19.83, by L. F. CASHION.....