


T.5S., R. 7&8W., W.M.

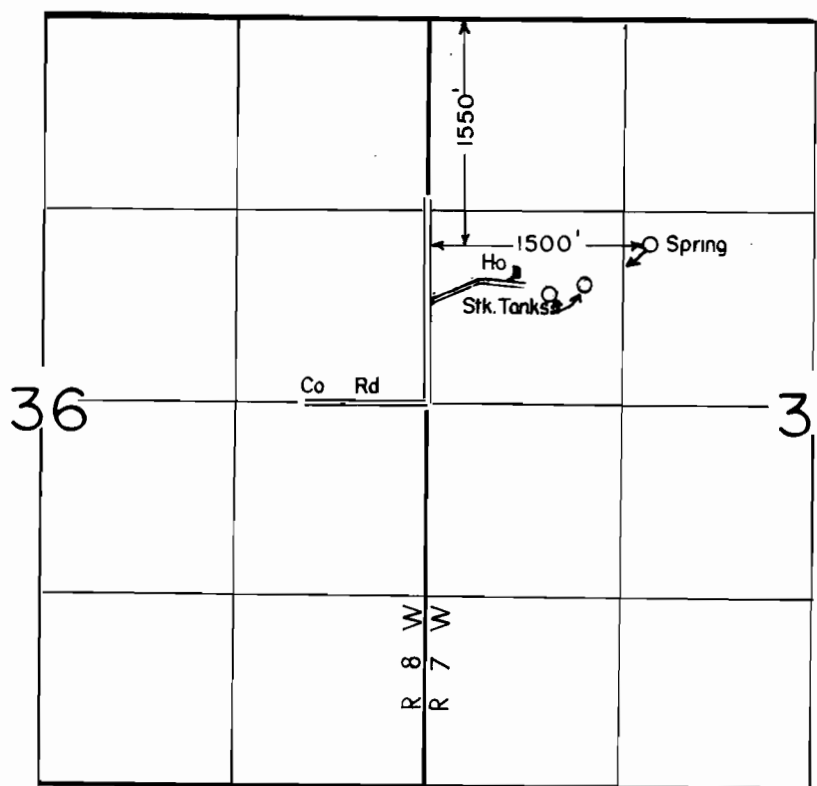

SCALE: 1" = 1320'

FINAL PROOF SURVEY
UNDER

Application No. 68030... Permit No. 48511.....
IN NAME OF

..SHARON..MARIE..KELLOGG..PALANUK

Surveyed .MAY..4.... 1989., by .J.M.WARREN.....