


T. 27 S., R. 13 W., W.M.
SECTION I

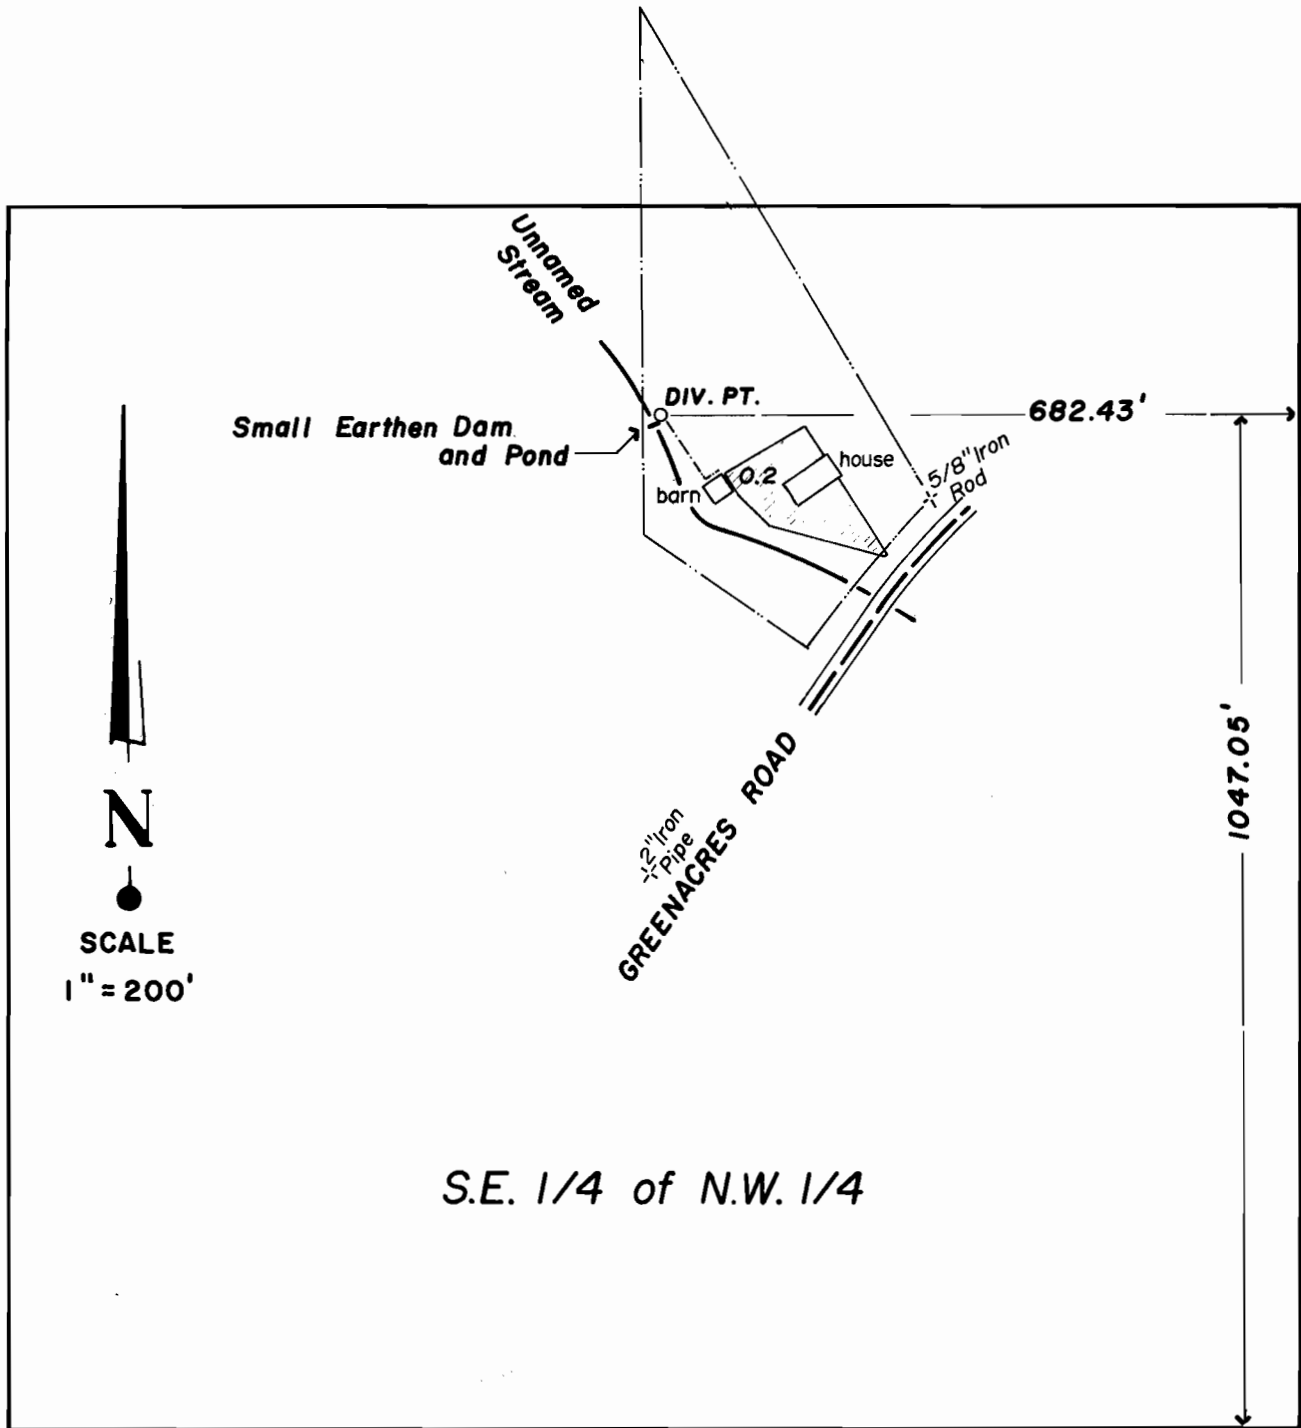

FINAL PROOF SURVEY
UNDER

Application No. 69460 Permit No. 50377
IN NAME OF

GARY L. FELLOWS

Surveyed Nov. 22, 1988, By R. S. Dodge