


T. 2N. R. 26E. W. M.

75848  
52085  
L4190  
72774

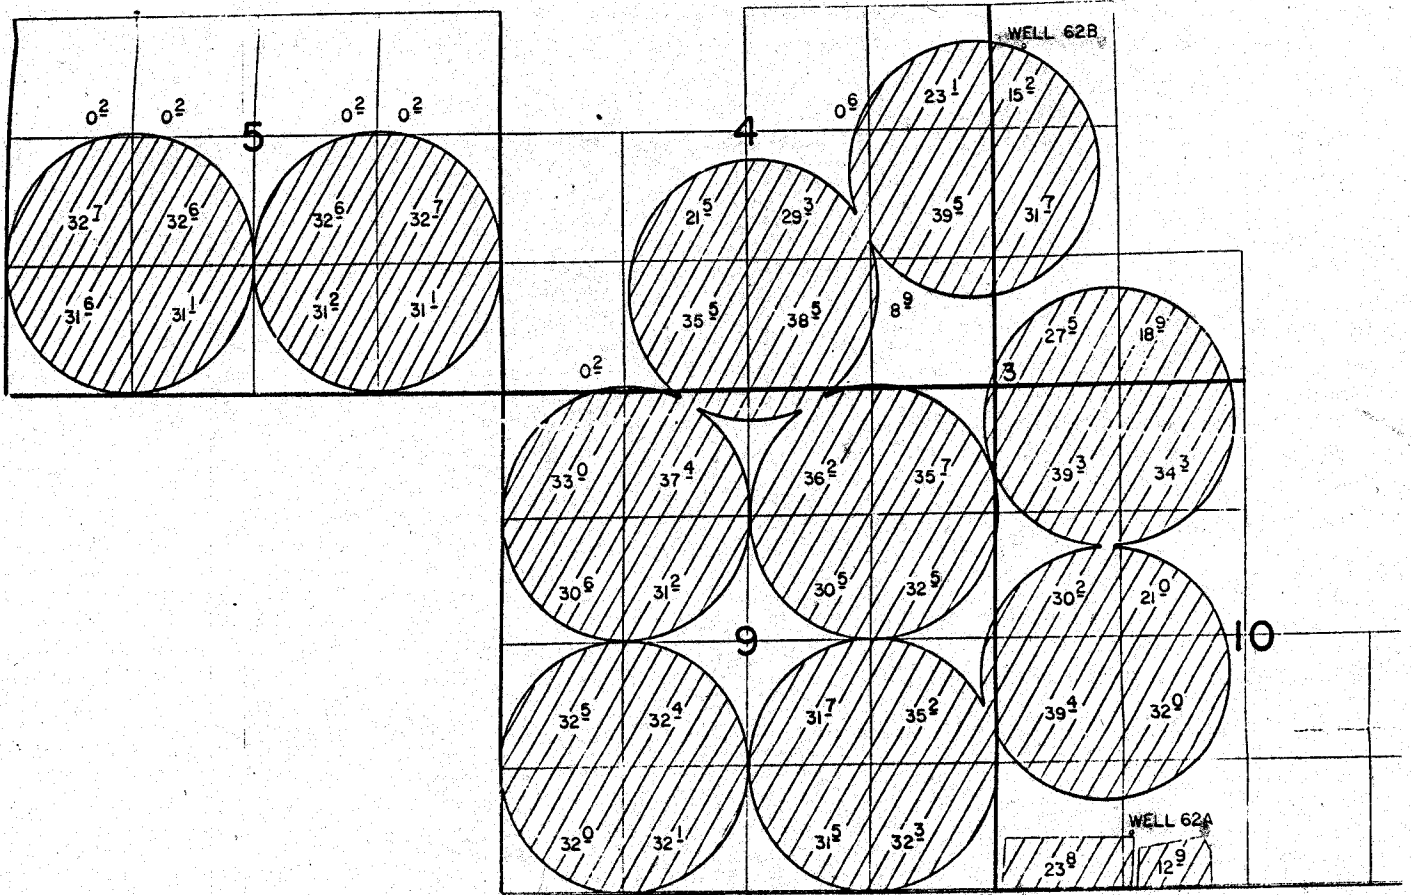

WELL 62B LOCATED 3500'N & 350'E FROM SW COR SEC 3 T. 2N., R. 26E. W.M.  
 WELL 62A LOCATED 560'N & 1450'E FROM SW COR SEC 10 T. 2N., R. 26E. W.M.  
 WELL 62 LOCATED 3700'S & 1790'E FROM NW COR SEC 23 T. 2N., R. 26E. W.M.

**FINAL PROOF SURVEY**  
 UNDER


APPL. NO. G-5096

PER. NO. G-4918

NOT TO SCALE

*As large as possible*  
*map*

IN NAME OF  
**CONNECTICUT GEN. LIFE INS. CO.**  
 SURVEYED MAY 3, 1979 by R. BARWIN

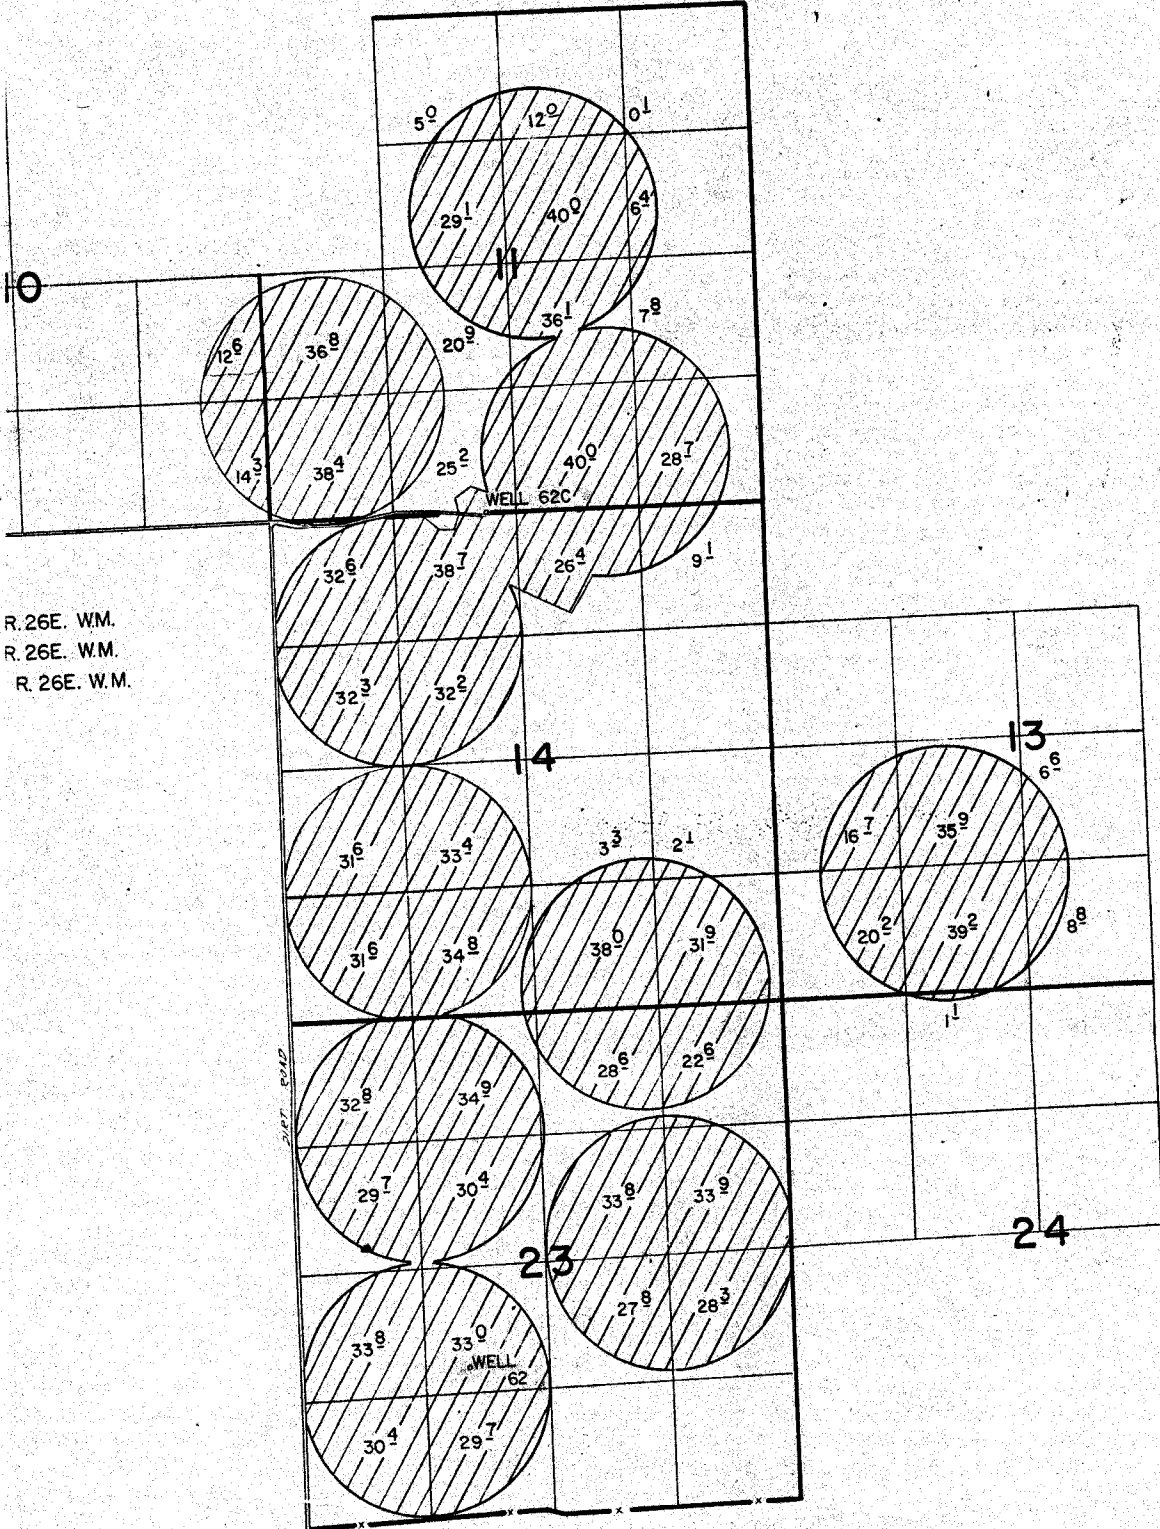

R. 26E. W.M.  
 R. 26E. W.M.  
 R. 26E. W.M.

NOT TO SCALE

*See large map file*

T2N R26E W.M.

SABRE PHOTO 1-7 11:10  
 PFS-1978-P-A  
 V.L.C.