
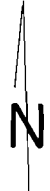


T. 4 S., R. 3 W., W. M.

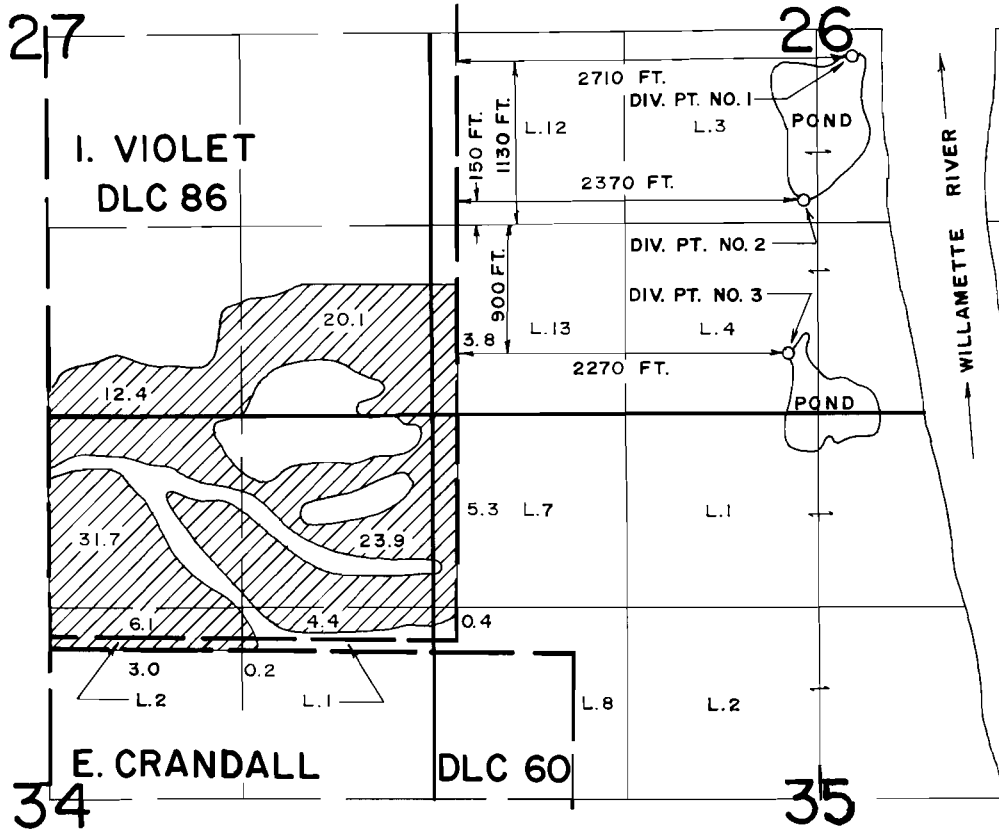

FINAL PROOF SURVEY UNDER

SCALE: 4" = 1 MILE

Application No. 58838 Permit No. 44392
IN NAME OF

WIL & BARBARA WILSON

Surveyed MAY 16, 1984, by P. P. [Signature]