
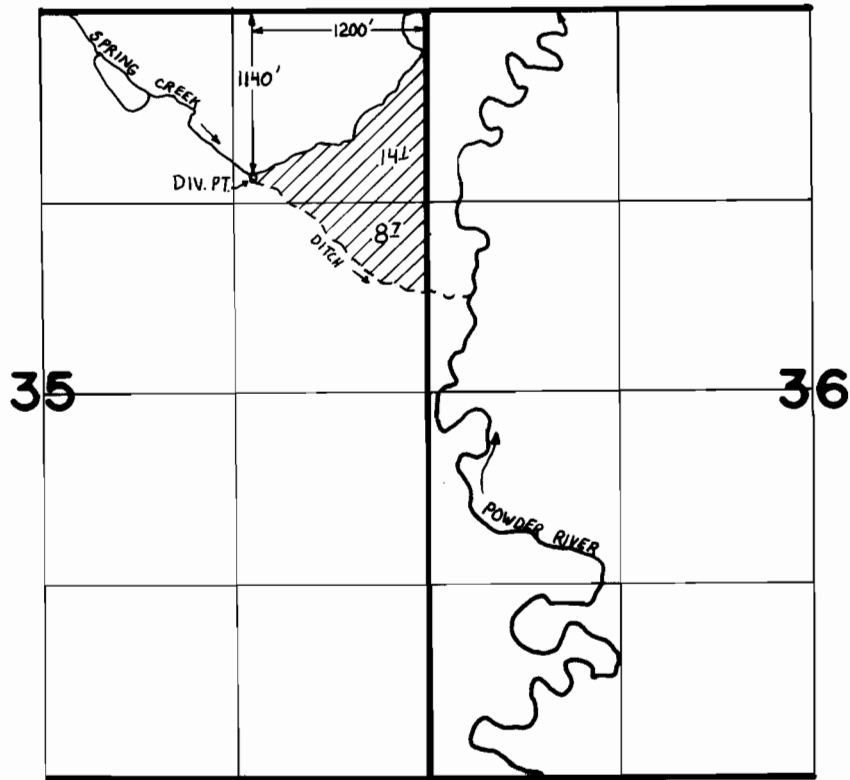


**T. 6 S. R. 39 E. W.M.**

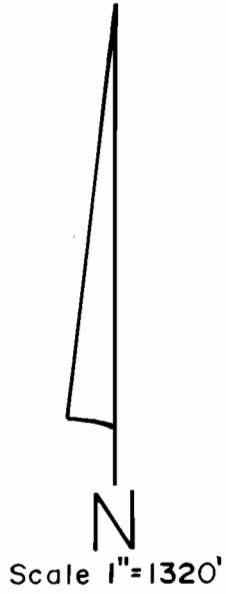

**FINAL PROOF SURVEY  
UNDER**

Application No. 59,892. Permit No. 45052.....  
IN NAME OF

**ARTHUR E. POWELL**

Surveyed Aug. 26, 1986, by V. Church.....