


RECEIVED

NOV - 5 1985.

WATER RESOURCES DEPT
SALEM, OREGON

T.2N. R.11E. W.M.

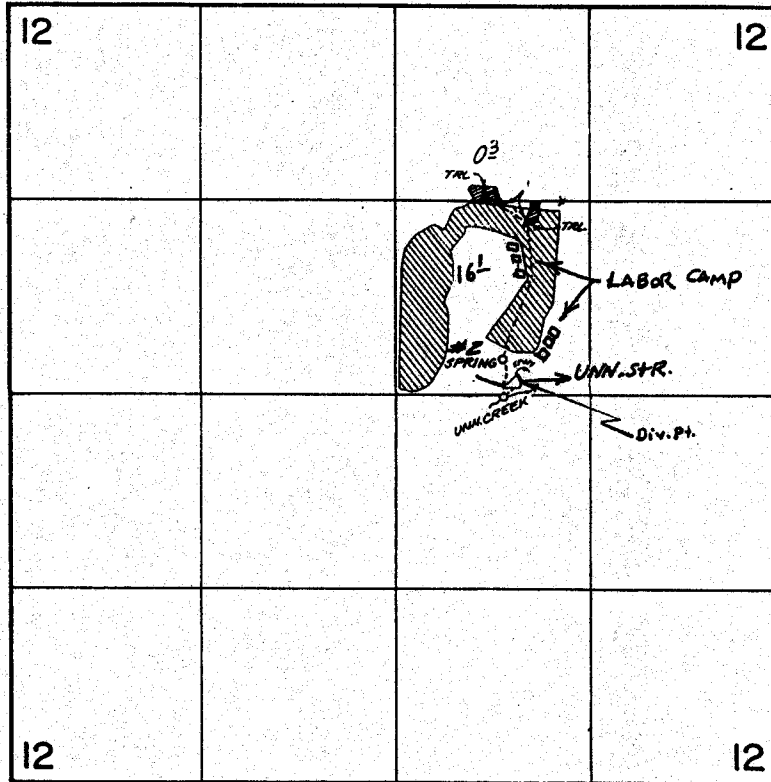

SPRING 240'N. (720' E.)
both FROM CENTER SECTION 12.

Unnamed Stream 100'N. (880' E.)

Application No. 68581
Permit No. 49577