


T.27 S.R.12W.W.M.

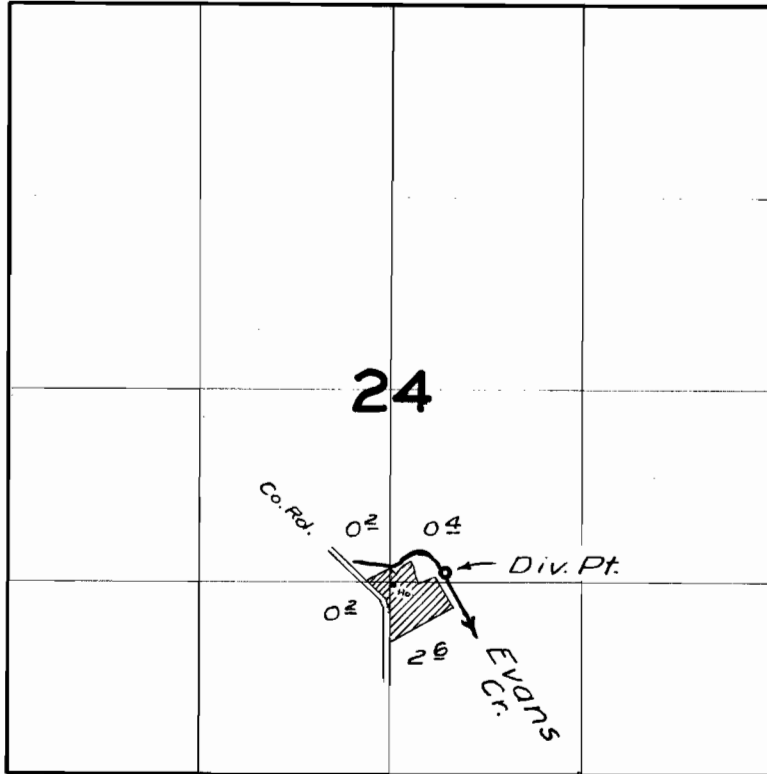

FINAL PROOF SURVEY
UNDER

Application No. 28309 Permit No. 22258
IN NAME OF

Robert O. Gardner

Surveyed May 23 1958, by M. Bisher