


T.3S. R.1E.W.M.

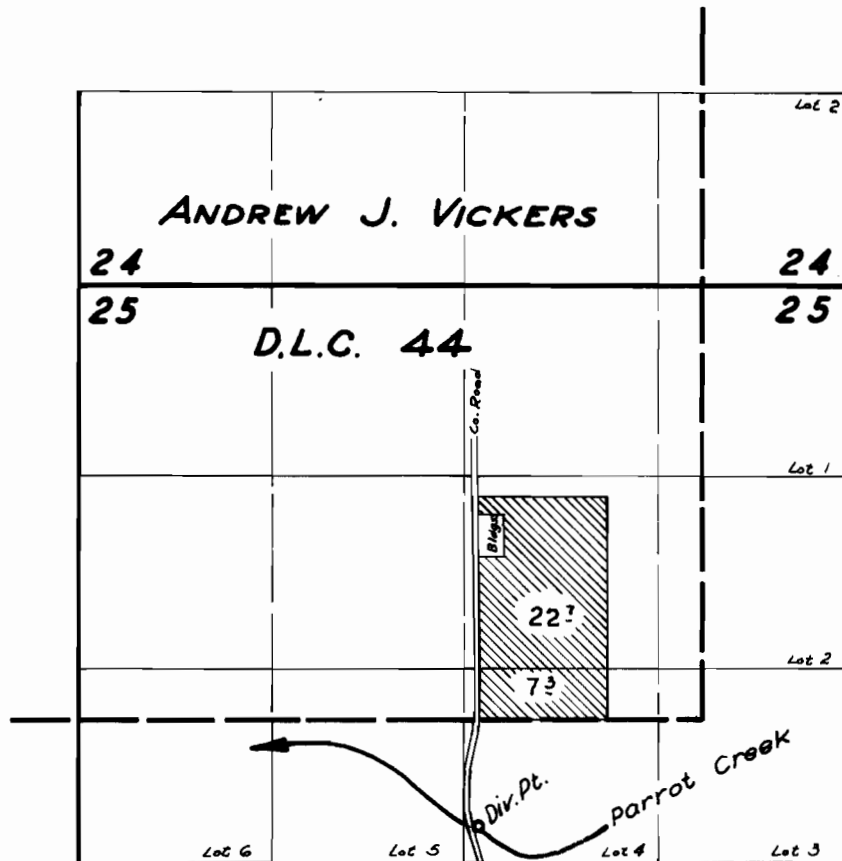

FINAL PROOF SURVEY
UNDER

Application No. 30227... Permit No. 23829
IN NAME OF

GORDON L. SCHOONOVER

Surveyed 7 Oct. 1958, by C. O. Bartels.