


T. 37S. R. 36 E. W.M.

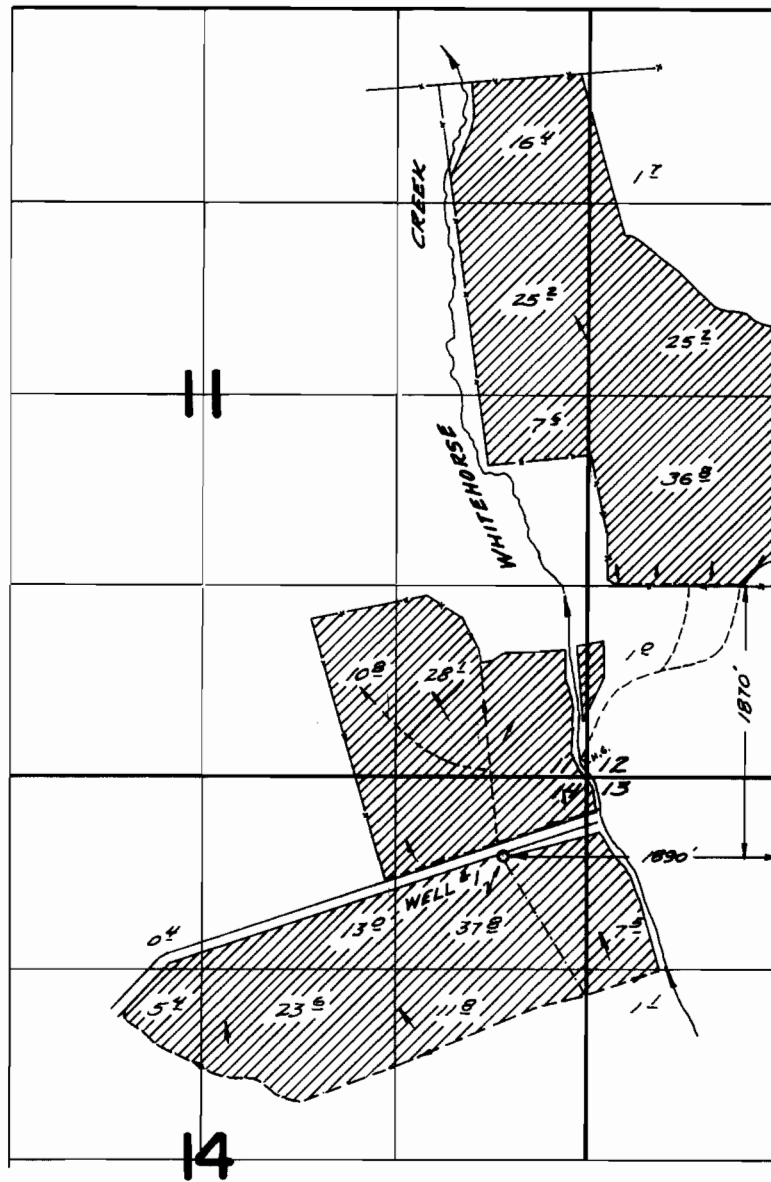

FINAL PROOF SURVEY UNDER

Application No. G-2233. Permit No. G-2056.
IN NAME OF

.....WHITEHORSE RANCH INC.....

Surveyed Aug 3, 1968, by V. Garner.....