


T. 8S. R. 4W. W.M.

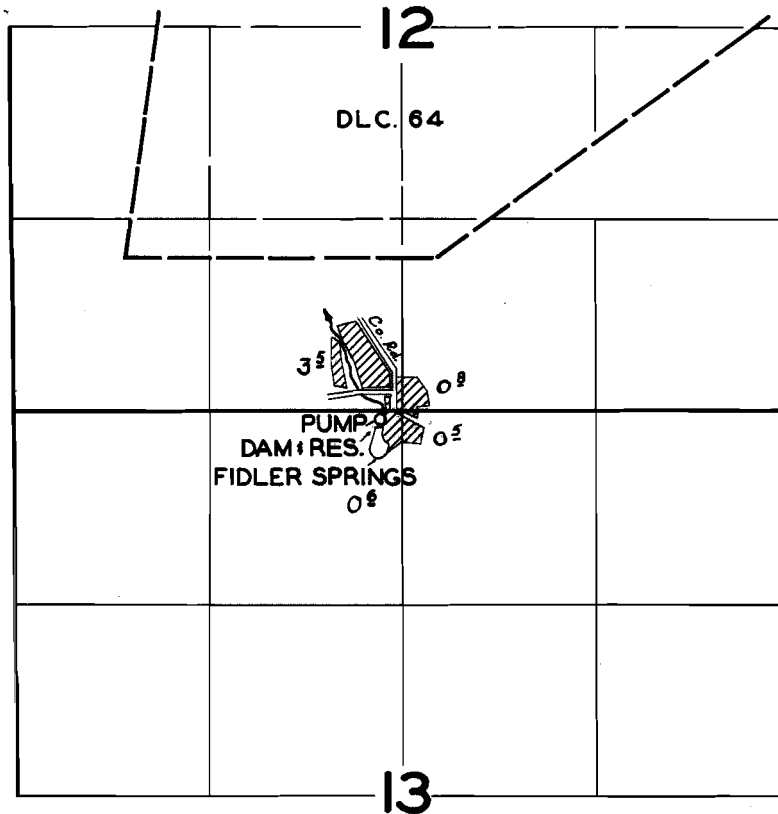

**FINAL PROOF SURVEY**

UNDER

R-27590

R-1586

Application No. 27591 Permit No. 22732

IN NAME OF

**EDNA M. BARKER**

Surveyed APR. 4. 1957, by C.O. BARTELS