


T. 28 S. R. 7 W. W. M.

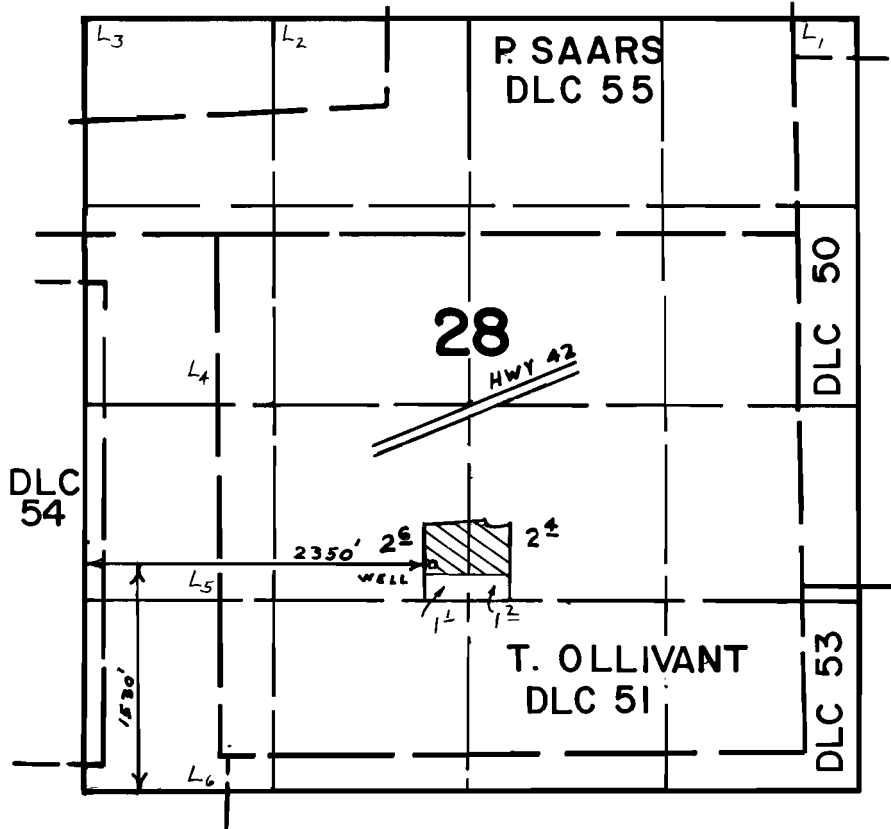

SCALE: 4" = 1 mile

**FINAL PROOF SURVEY**  
UNDER

Application No. G-7403 Permit No. G-785.9  
IN NAME OF

.....LESTER B. JONES.....

Surveyed JUNE 4, 1979, by S. DONALDSON