


T.24 S. R.33 E. W.M.

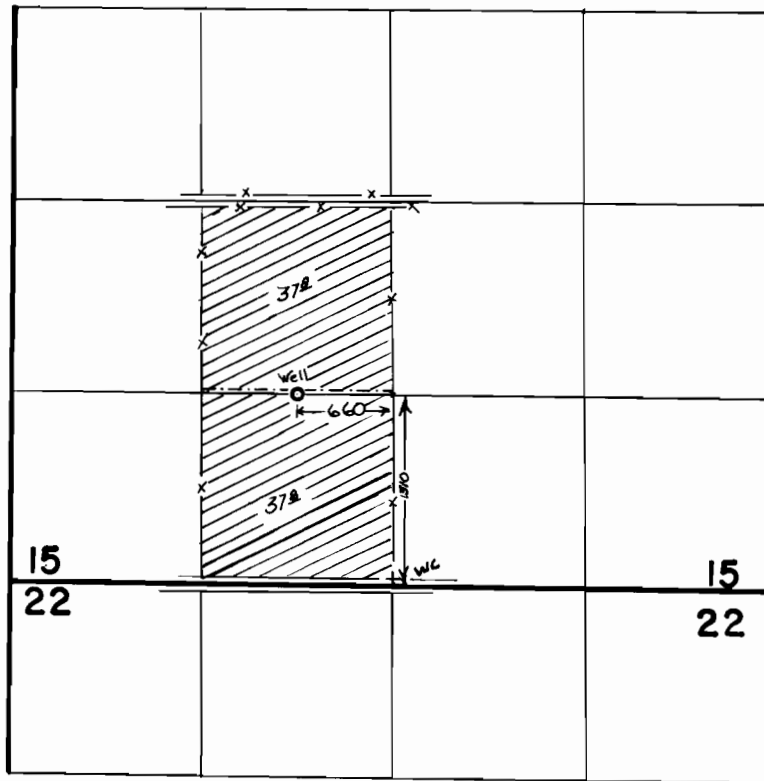

FINAL PROOF SURVEY
UNDER

Application No. G-8185 Permit No. G-7641.....
IN NAME OF

G. & R. TRUCKING COMPANY.....

Surveyed JULY 28, 1979, by R.G. Mucken.....