G7875
64240

T. 6N., R. 34E., W.M.

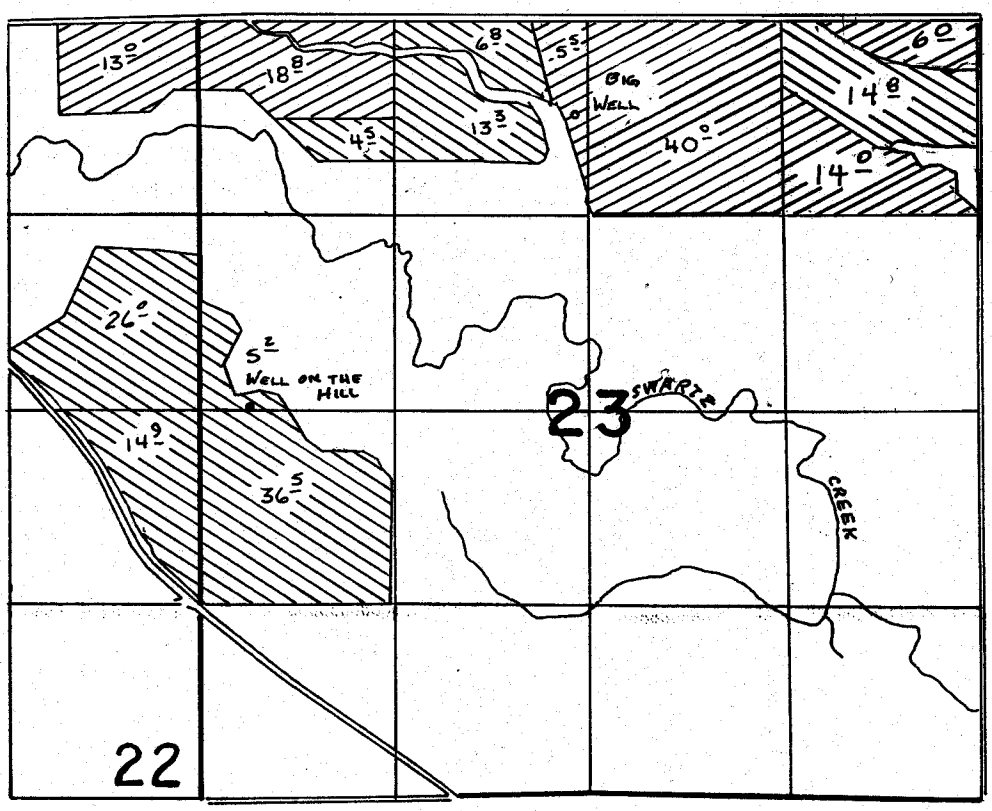

WELL 1 LOCATED 10'N. & 350'E. FROM W¼ COR. SEC. 23
WELL 2 LOCATED 650'S. & 90'W. FROM N¼ COR. SEC. 23

PRIMARY SUPPLEMENTAL

SCALE: 1"=1320'

FINAL PROOF SURVEY
UNDER

Application No. G:8472 Permit No. G:7875
IN NAME OF

COUSE CREEK RANCH INC.

Surveyed 4-10 19 84, by V.L. Church

ZSLF V. L. C.