


T.27S.,R.18E.,W.M.

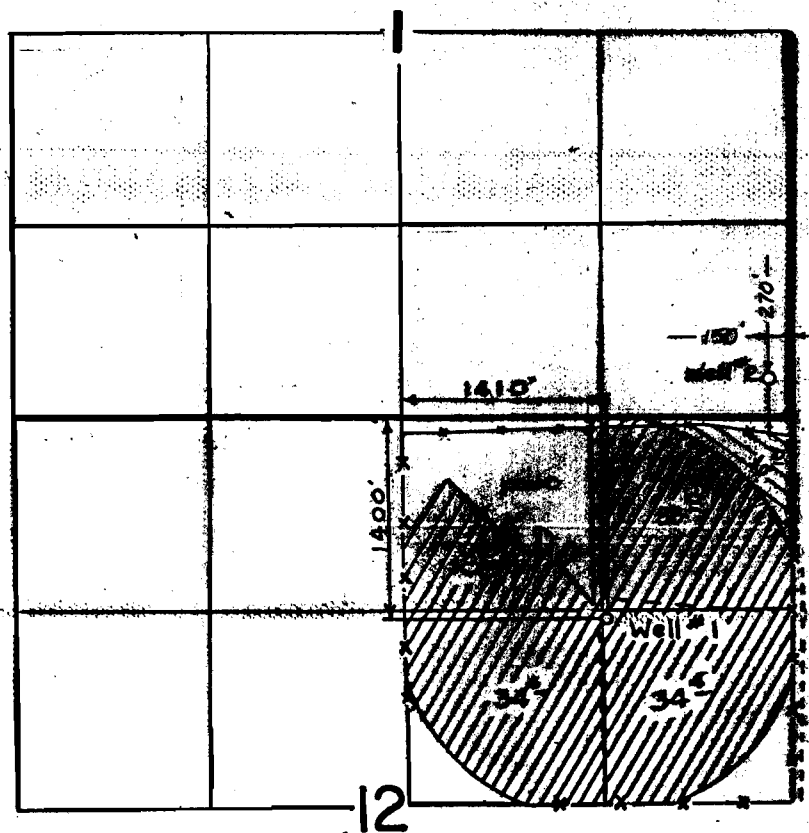

SCALE: 1" = 1320'



SCALE: 1" = 1320'

FINAL PROOF SURVEY
UNDER

G-9778 G-9022
Application No. G-10528 Permit No. G-9691
IN NAME OF

 WELL #1
 WELL #2

.....FLOWERREE FARMS INC.....

Surveyed APRIL 16, 1985., by LESLIE OLSON....

Revised: 2-12-90 *gal*

PTS H-1985A MJM

REVISED 2/89 41037-370 202-L