


T.15 & 16S.,
R. 43 E.,
W.M.

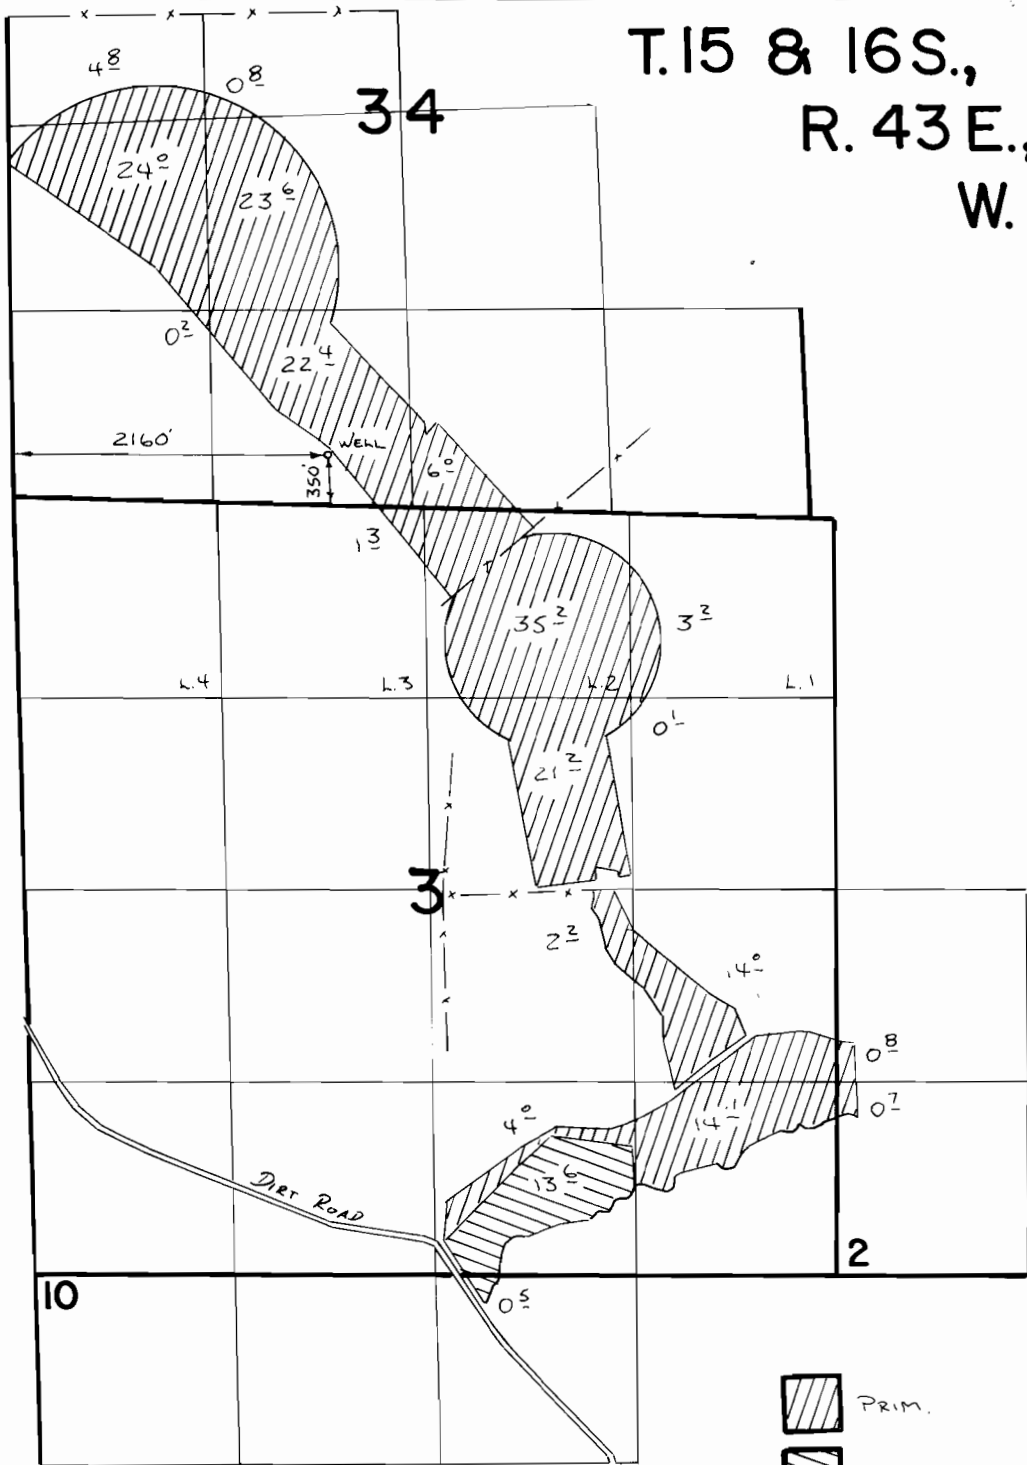

FINAL PROOF SURVEY
UNDER

Application No. **G-9852**. Permit No. **G-9059**
IN NAME OF

WATER RESOURCES DEPT.

Surveyed *5-25* 1988, by *V.L. Church*