


T.13S., R.15E., W.M.

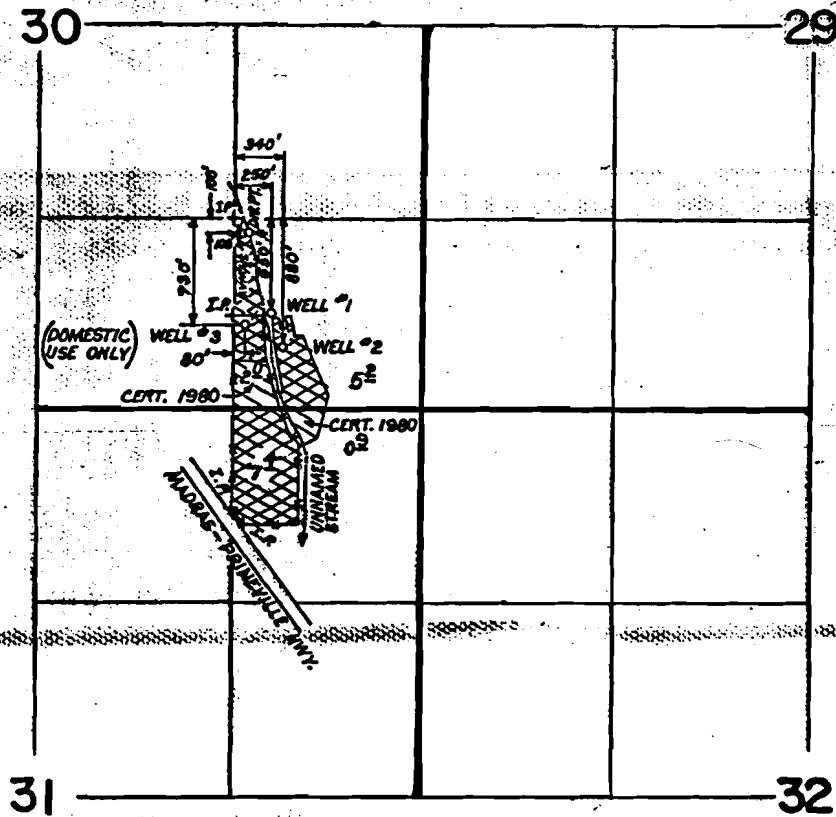

SCALE: 1" = 1320'

FINAL PROOF SURVEY
UNDER

G-10188 G-9521  supp - Certificate #64245
Application No. 61303 Permit No. 46168
IN NAME OF

ROYCE N. & SANDRA D. KIRK

Surveyed JULY 2, 1985, by LESLIE OLSON