


T.14S., R.12E., W.M.

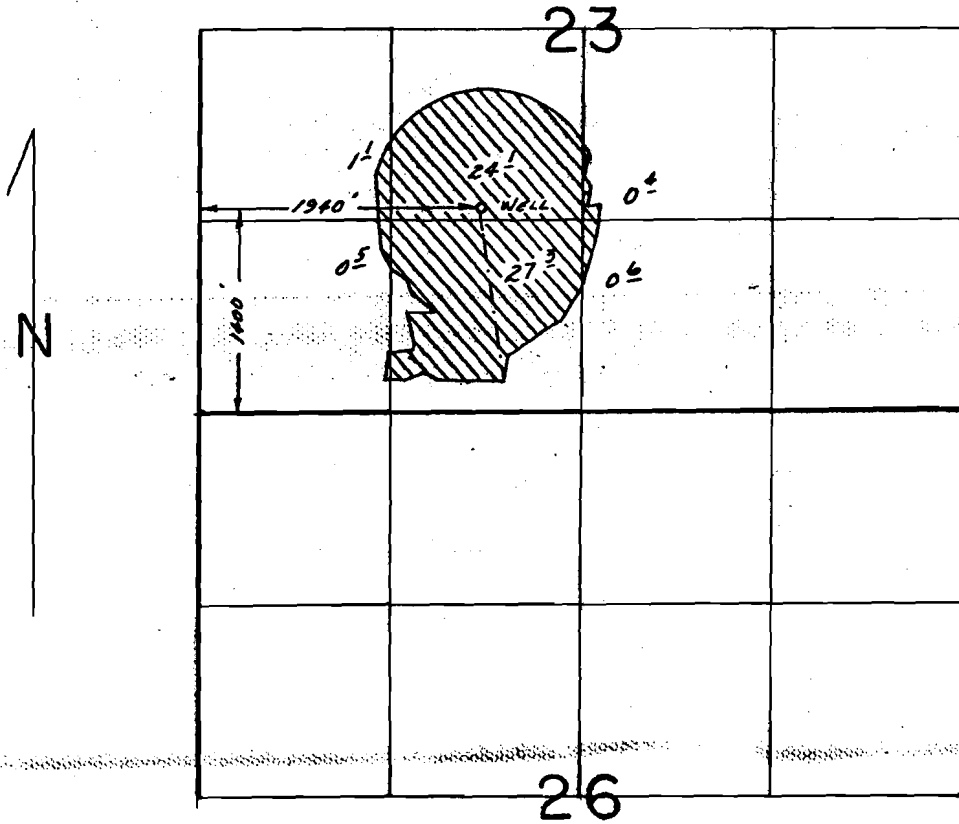

SCALE: 1" = 1320'

FINAL PROOF SURVEY
UNDER

Application No. G-10234 Permit No. G-9374..... Cert. 64246
IN NAME OF

.....ROBERT H. MAYFIELD.....

Surveyed Oct. 11..... 1988., by B.W. BISHOP.....

11/2/88 BJB
PTS 11-1988

G 9374