


T. 1 N. R. 12 E. W. M.

Scale: 8" = 1 mile

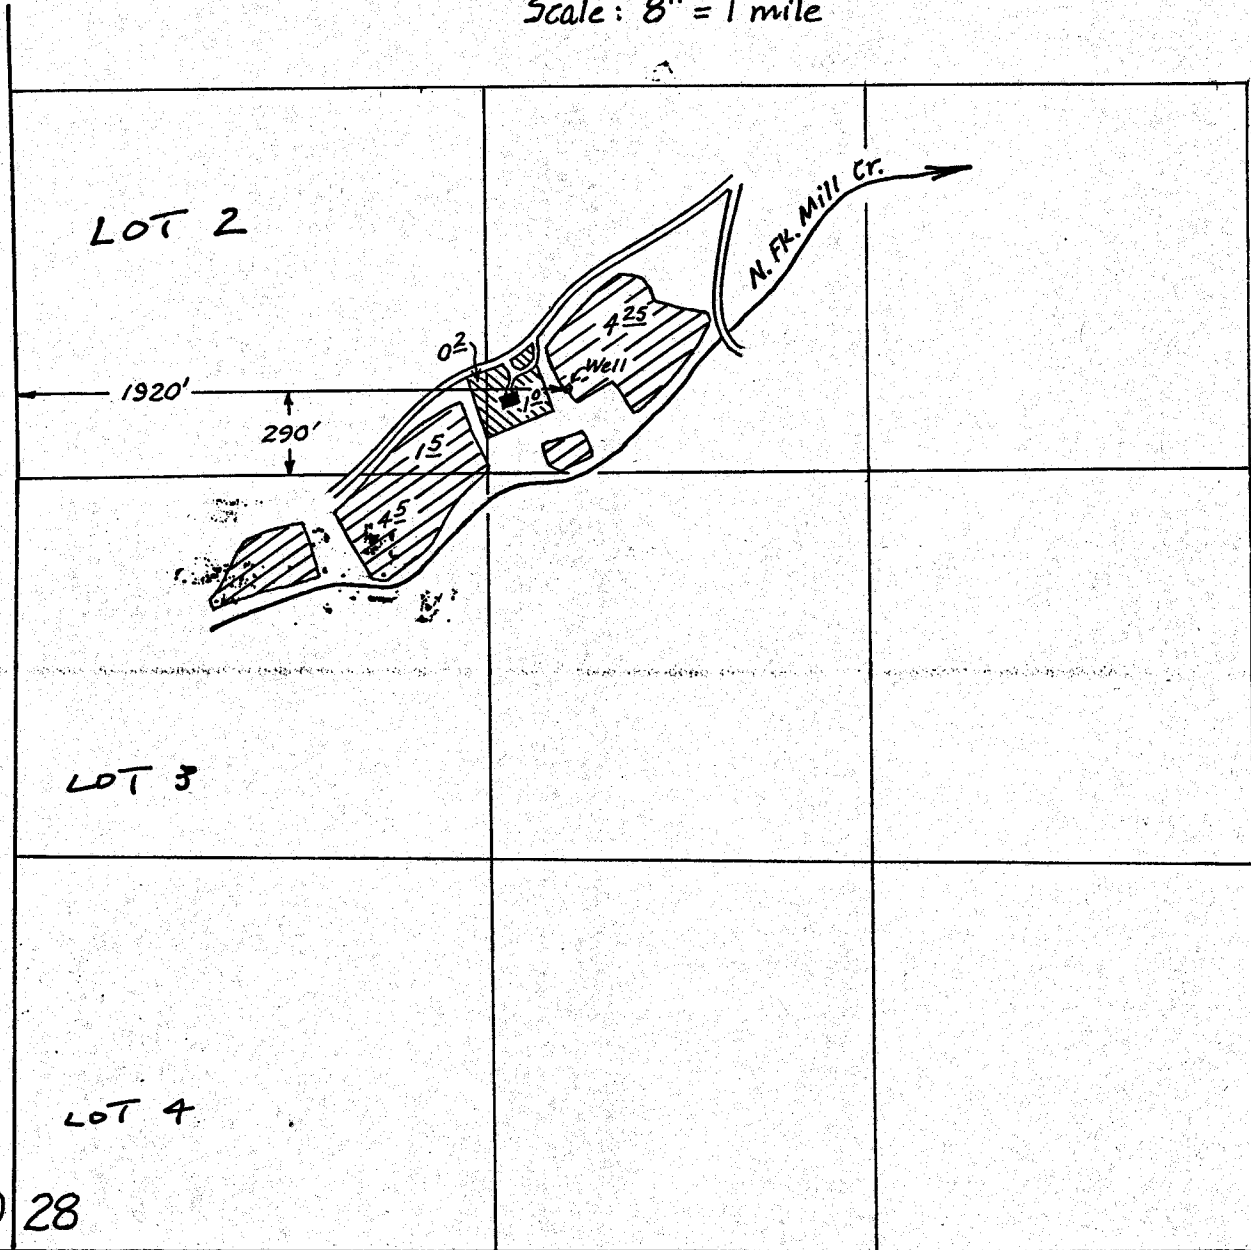

29 28


32 33


Application No. G 10390
Permit No. G 9581

RECEIVED

JUN 19 1981

WATER RESOURCES DEPT
SALEM, OREGON

 Primary

 Supplemental to Cert. 5712