


T. 17S., R. 40 & 41E., W.M.

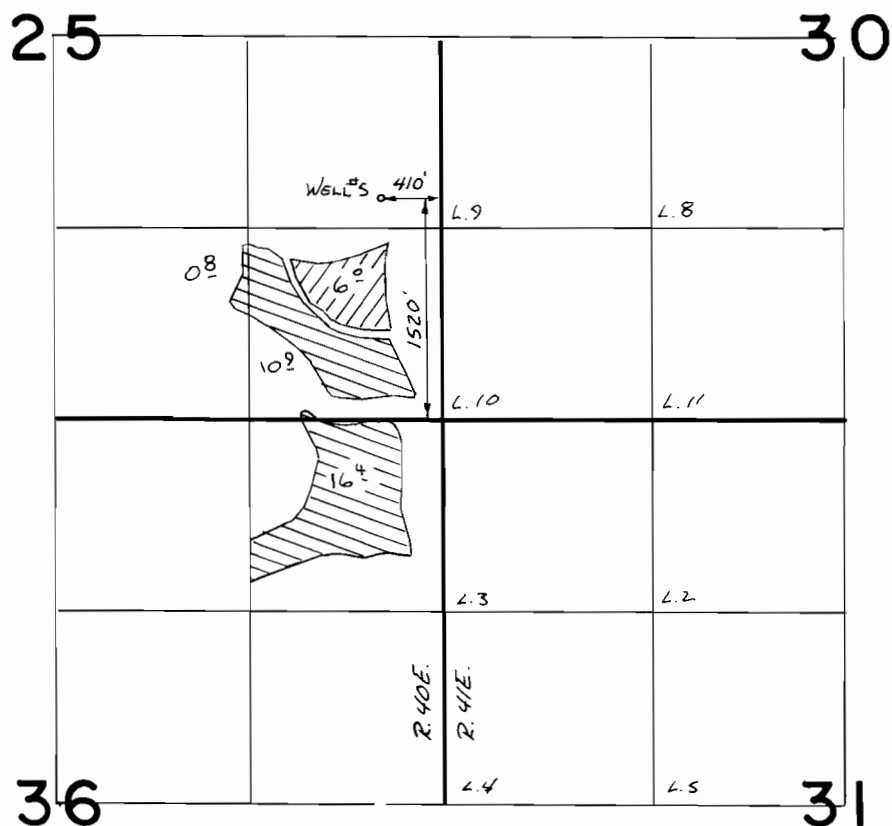

Scale 1" = 1320'



SUPPL



PRIM

FINAL PROOF SURVEY UNDER

Application No. **G-10524** Permit No. **G-9940**
IN NAME OF

JORDAN CATTLE COMPANY

Surveyed **5-24** 19**88**, by **V.L. Church**