


G9691
64249

T.27S.,R.18E.,W.M.

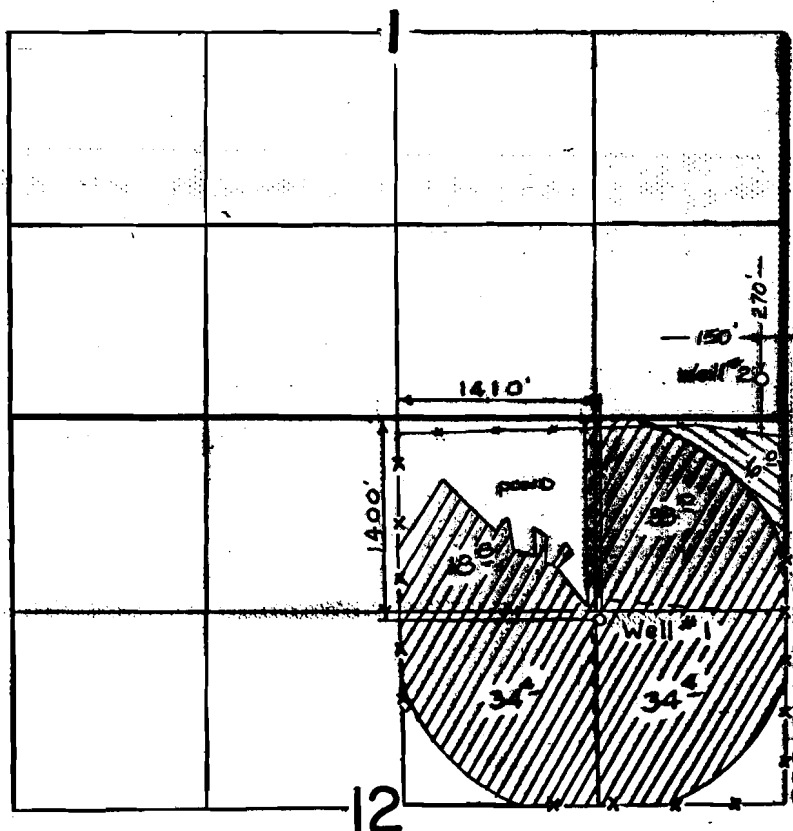

SCALE: 1" = 1320'



SCALE: 1" = 1320'

FINAL PROOF SURVEY

UNDER

G-9778 G-9022
Application No. G-10528 Permit No. G-9691
IN NAME OF



FLOWERREE FARMS INC.

Surveyed APRIL 16, 1985, by LESLIE OLSON

Revised: 2-12-90

PTS 11-1985A

MJM

REVISED 2/89 4037-370
242-L