


T. 8S., R. 4W., W.M.

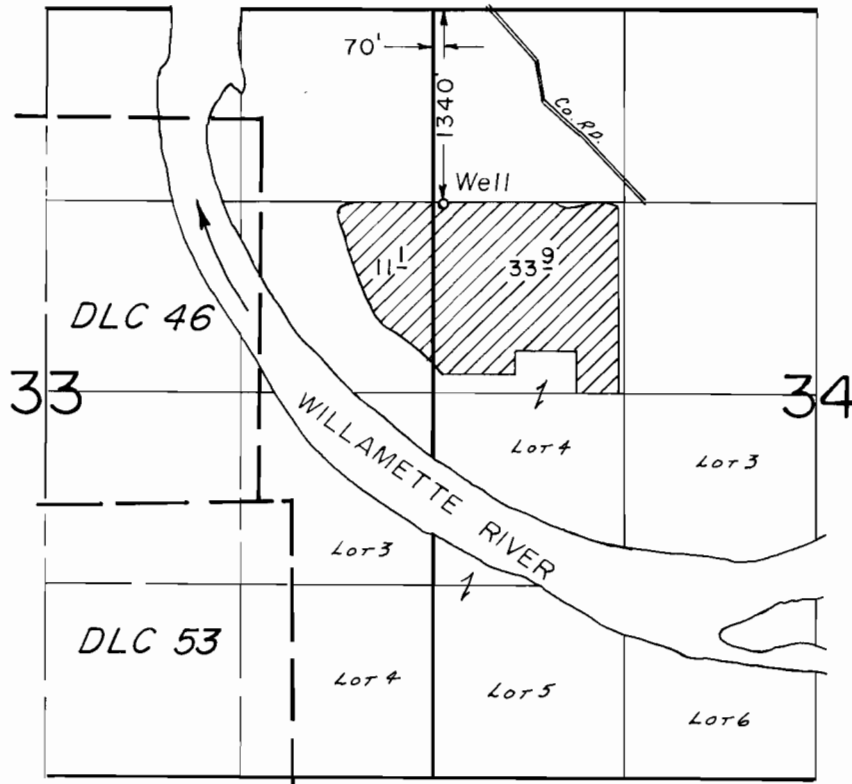

SCALE: 1"=1320'

FINAL PROOF SURVEY
UNDER

Application No. G-10610 Permit No. G-9725.....
IN NAME OF

.....MILLER FORESTS INC.....

Surveyed May 7..... 1984, by B.W. BISHOP.....