


T. 25S., R. 34E., W. M.

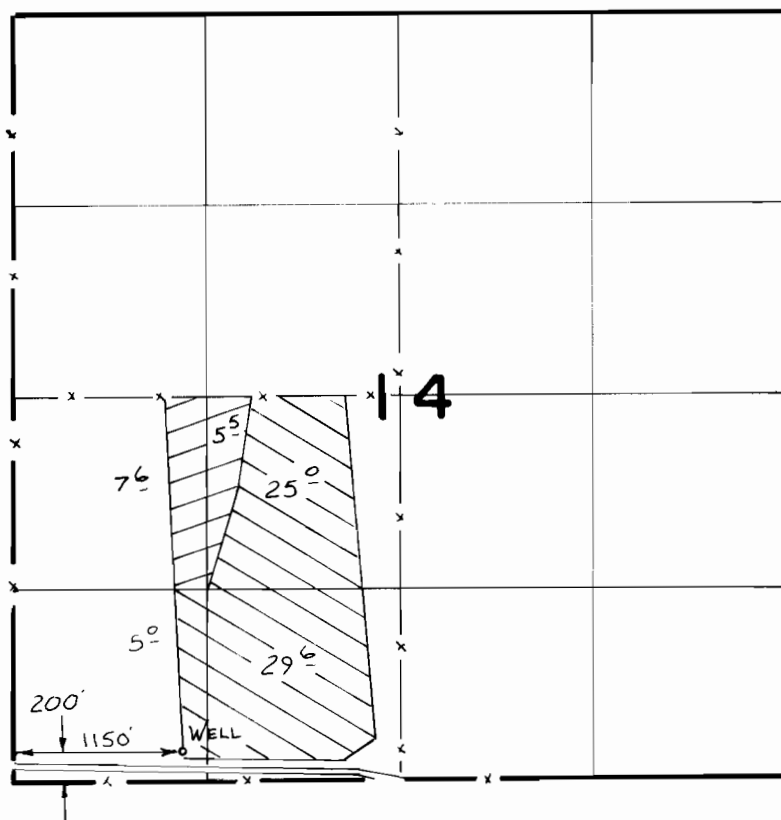

SCALE 1" = 1320'



PRIM



SUPP

FINAL PROOF SURVEY
UNDER

Application No. **G-10691** Permit No. **G-9813**
IN NAME OF

CANEVARI TIMBER CO. INC.

Surveyed 5-10 1988, by V.L. Chvrch