


T.9S., R.15E., W.M.

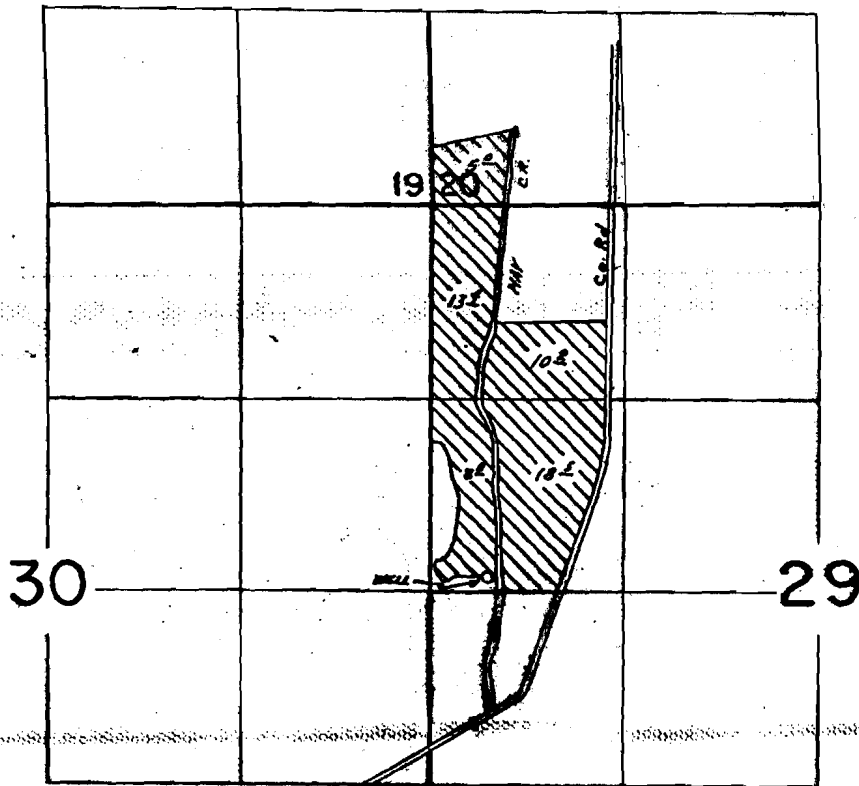

WELL LOC.: 70' N. & 370' E FROM N 1/4 COR. SEC. 29

SCALE: 1"=1320'

FINAL PROOF SURVEY
UNDER

Application No. G-1083 Permit No. G-10253
IN NAME OF

Cert. 64254

WILLIAM RUETER

Surveyed AUG. 16 1988, by B. BISHOP