
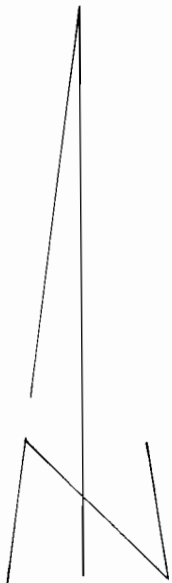


T. 25S., R. 34E., W.M.

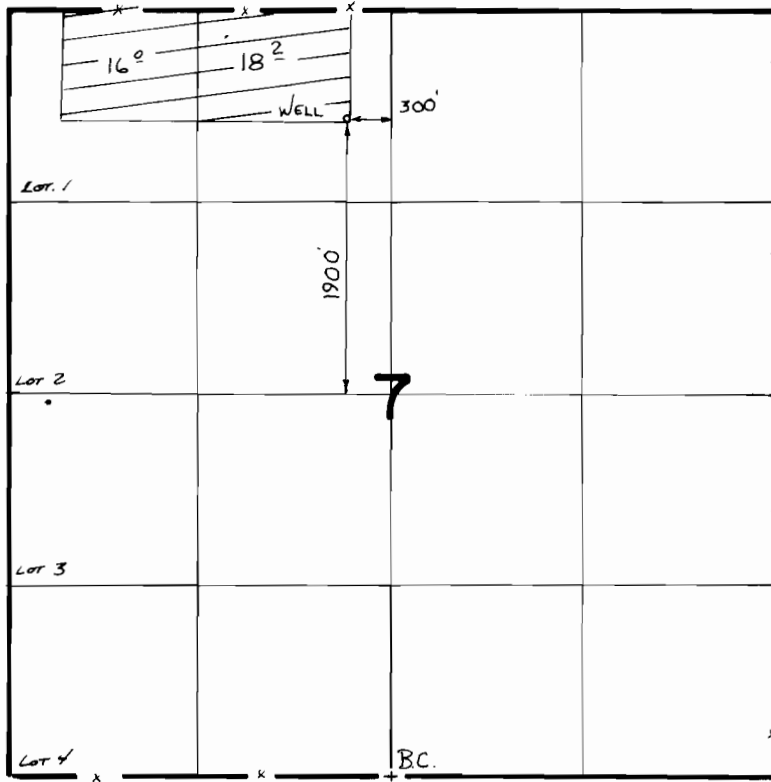

Scale 1"=1320'

FINAL PROOF SURVEY UNDER

Application No. **G:11364** Permit No. **G:10516...**
IN NAME OF

GEORGE & BEVERLY HOFFMAN.

Surveyed ...5-7... 1988, by *V. Churen*