


Application No. G-11418
Permit No. G10529

1001-1-1

RECORDED
INDEXED
MAY 1 1982

SALEM, OREGON DEPT. TEN RIDE W.M.

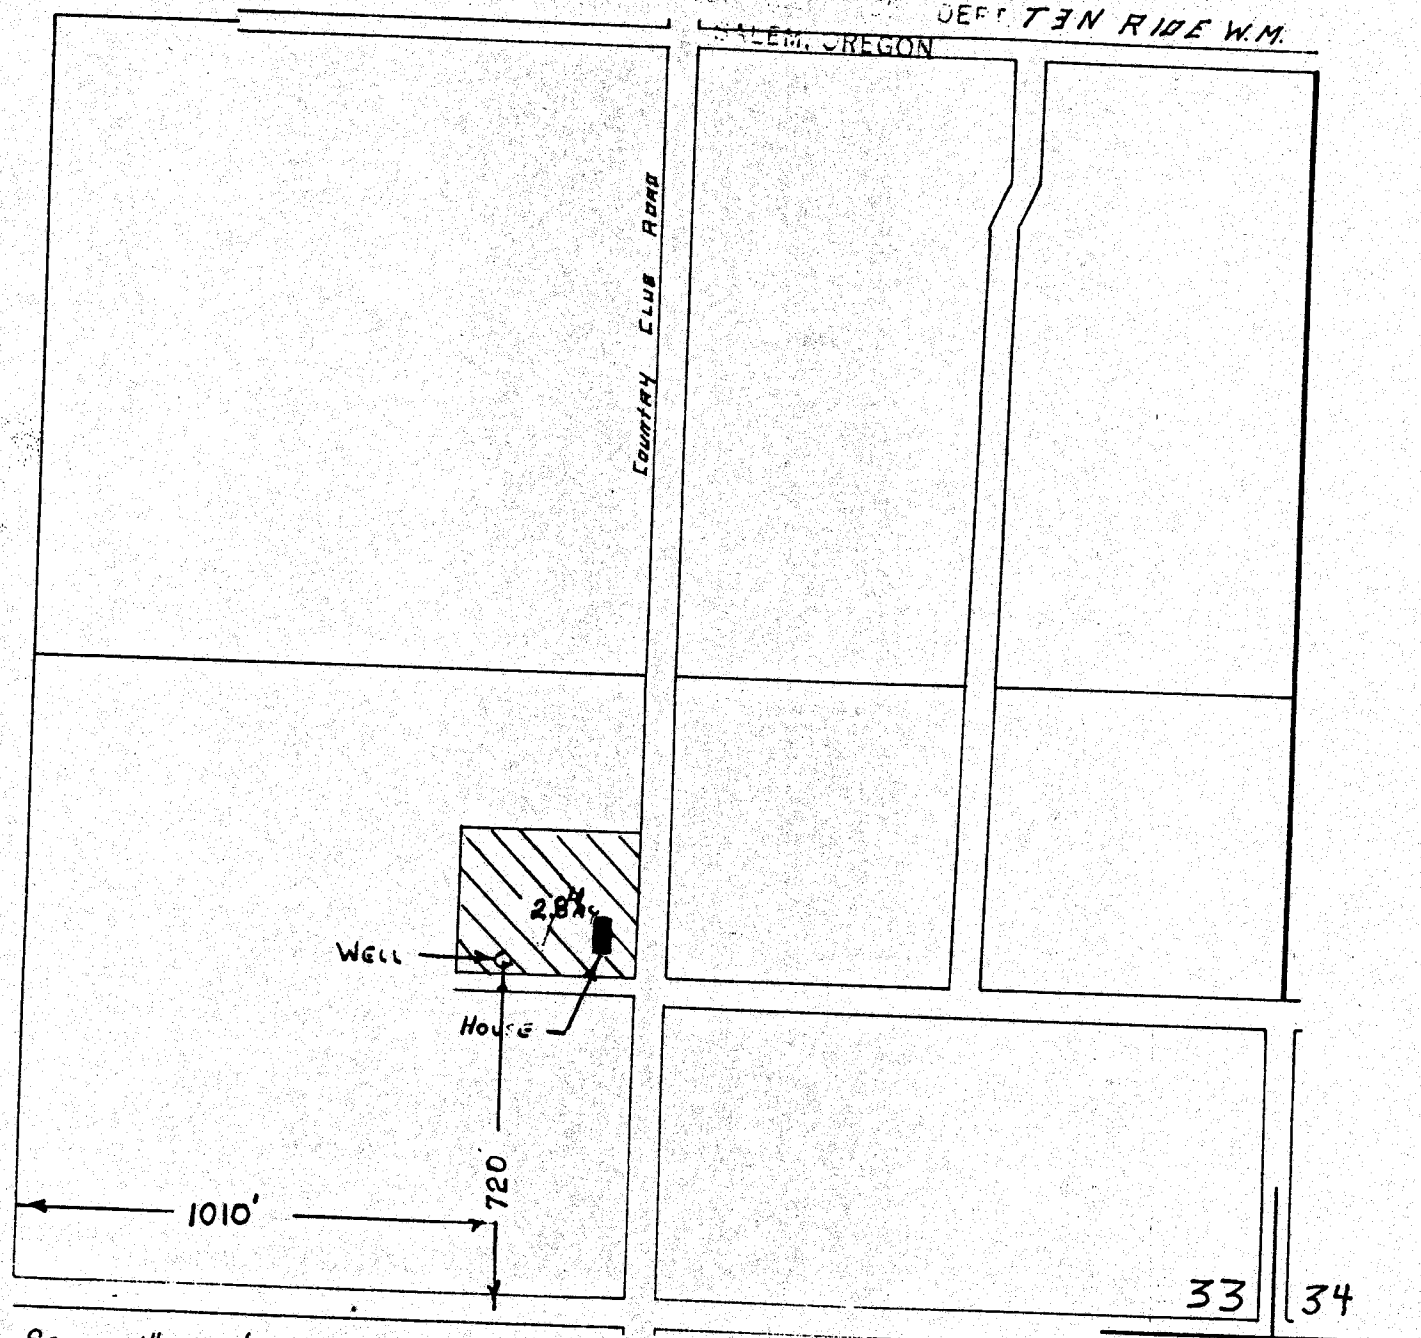

SCALE 1" = 400'

RICHARD M MILLS
860 COUNTRY CLUB RD.
HOOD RIVER OR.
97031

