


T. 10S. R. 3W. W.M.

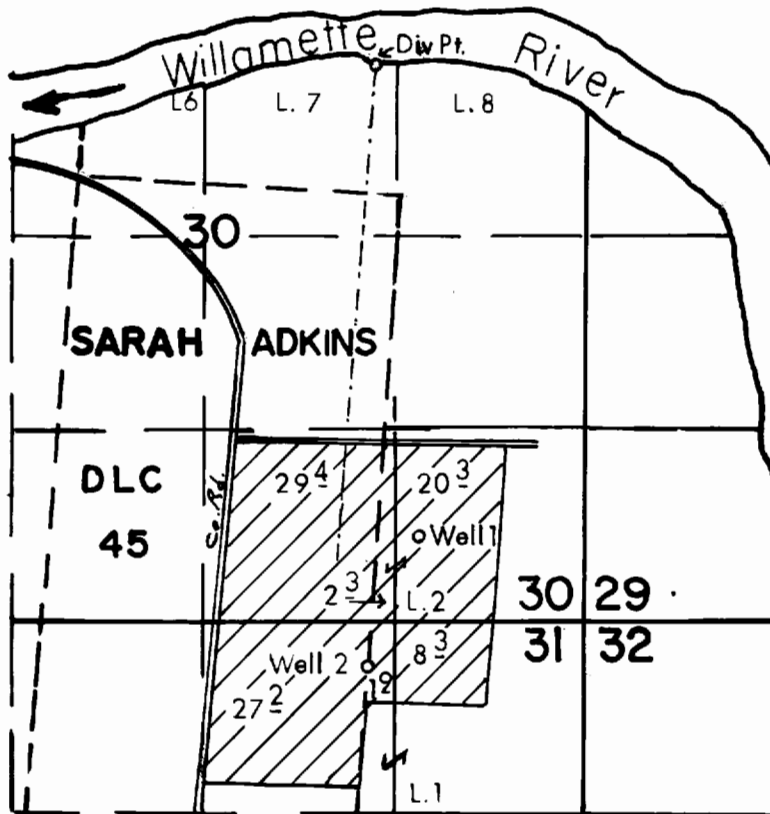

Well 1 Loc. 600' N. & 1150' W., Well 2 Loc. 300' S. & 1500' W., Div. Pt. Loc. 3850' N. & 1450' W. All From The S.E. Cor. Of Section 30

SCALE: 1" = 1320'

FINAL PROOF SURVEY UNDER

G-11608 G-10740

Application No. ~~68990~~ Permit No. ~~50007~~...

PRIM.
SUPPL.

IN NAME OF

AMMON BROS. INC.

Surveyed MAY 19 1988, by T.M. WARREN.....