


T. 5 S. R. 3 W. W.M.

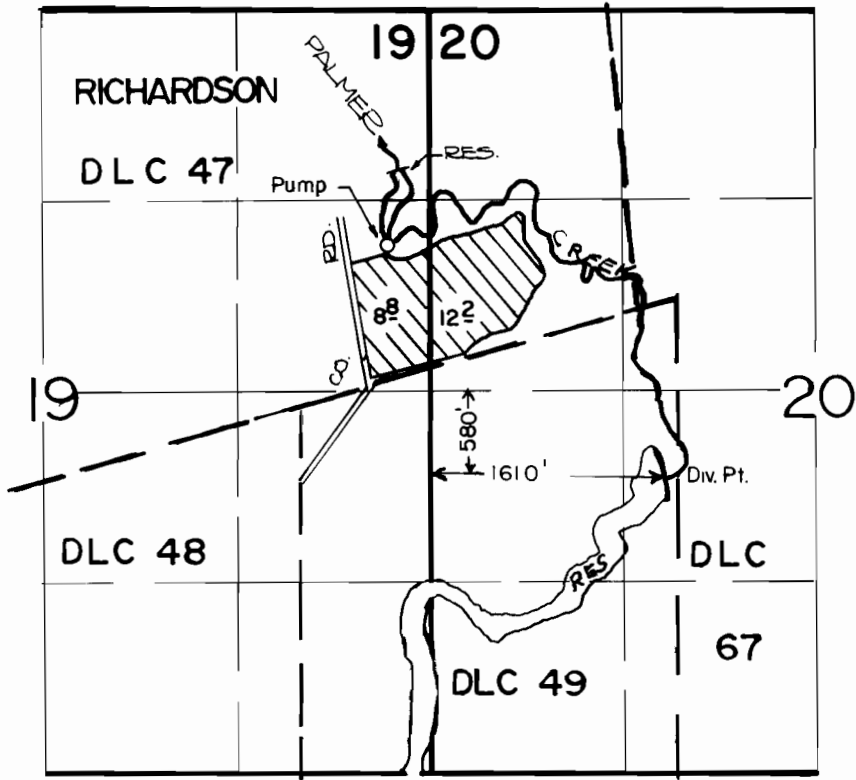

SCALE: 1" = 1320'

FINAL PROOF SURVEY
UNDER

Application No. 47075.. Permit No. 34733.....
IN NAME OF

HARVEY STOLLER

Surveyed OCT. 20 1983, by P. P. Patten