


T. 2S., R. 37E., W. M.

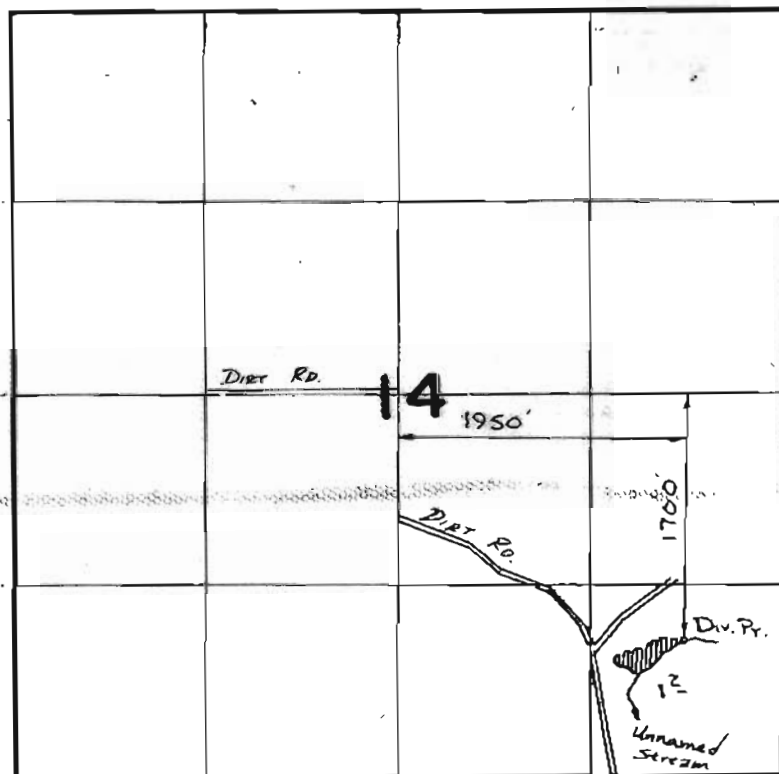

FINAL PROOF SURVEY
UNDER

Application No. **47433** Permit No. **35540**
IN NAME OF

JOHN P. & FLORENCE M. TROMMALT JR.

Surveyed **5-19** 19**88**, by **V.L. Church**

41061-179-107L

A1H-ZMM-101

6-13-89VLC