90684

T. 2 N., R. 2 W., W.M.

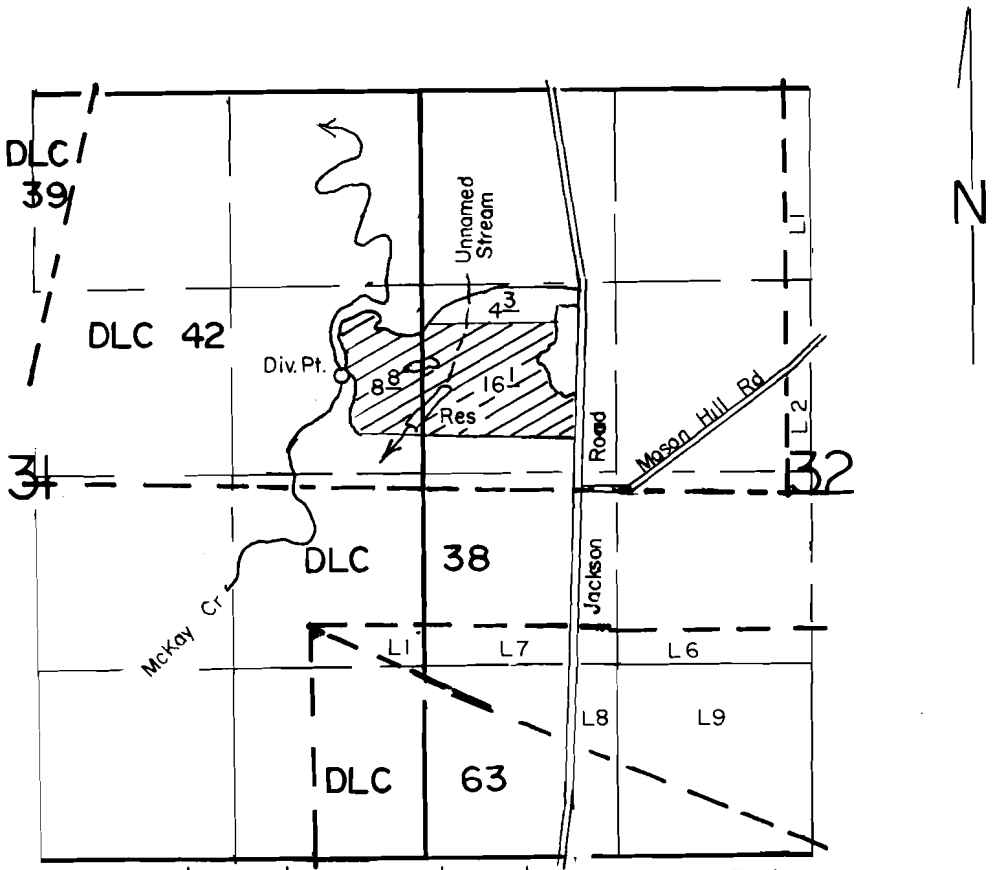

Div Pt Loc 700' N & 550', Res Loc 300' N & 100' W, Both From The E 1/4 Corner Of Section 31

SCALE: 1" = 1320'

FINAL PROOF SURVEY

UNDER

R-61911 R-8529
61912 47146

Application No. 55611 **Permit No.** 41667

IN NAME OF

GORDON E HOFFMAN

Surveyed JUNE 6 **19**89, **by** T.M. WARREN

41067-178155 L 9-29-89 DM