


T. 37 S., R. 3 W., W.M.

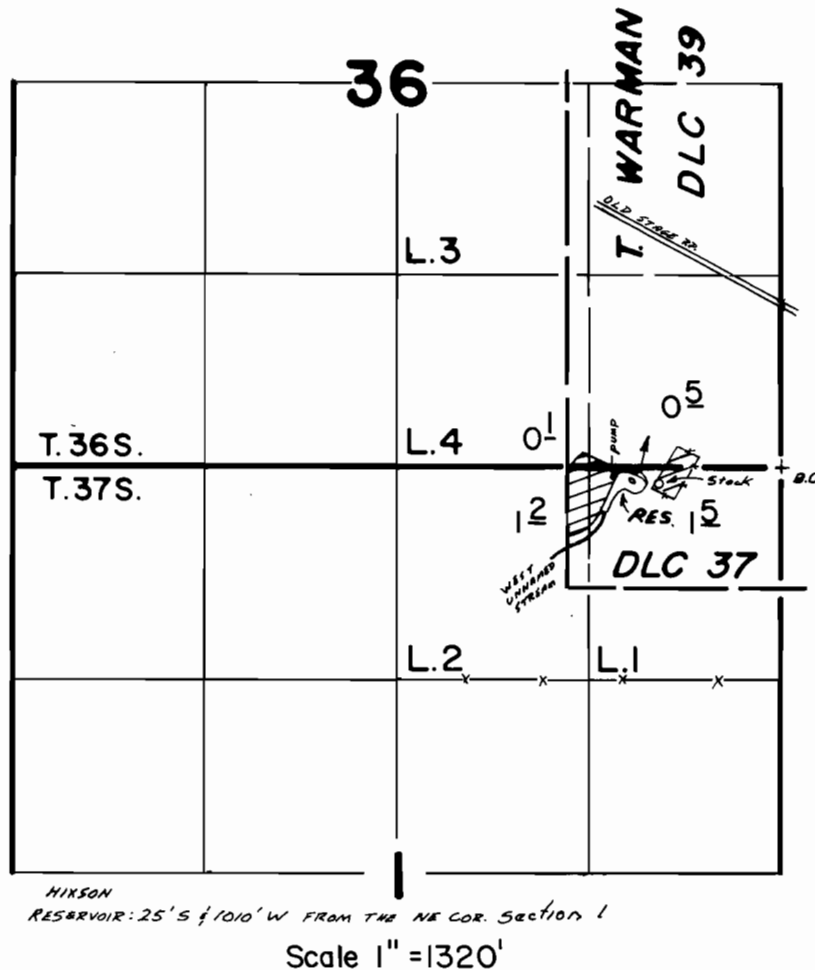

FINAL PROOF SURVEY
UNDER

R-50088

R-6054

Application No. 50089 Permit No. 37308
IN NAME OF

KENNETH R. HOLZMAN

Surveyed July 21, 1987, by B.S. JAMES