


T. 38 S., R. 8 W., W.M.

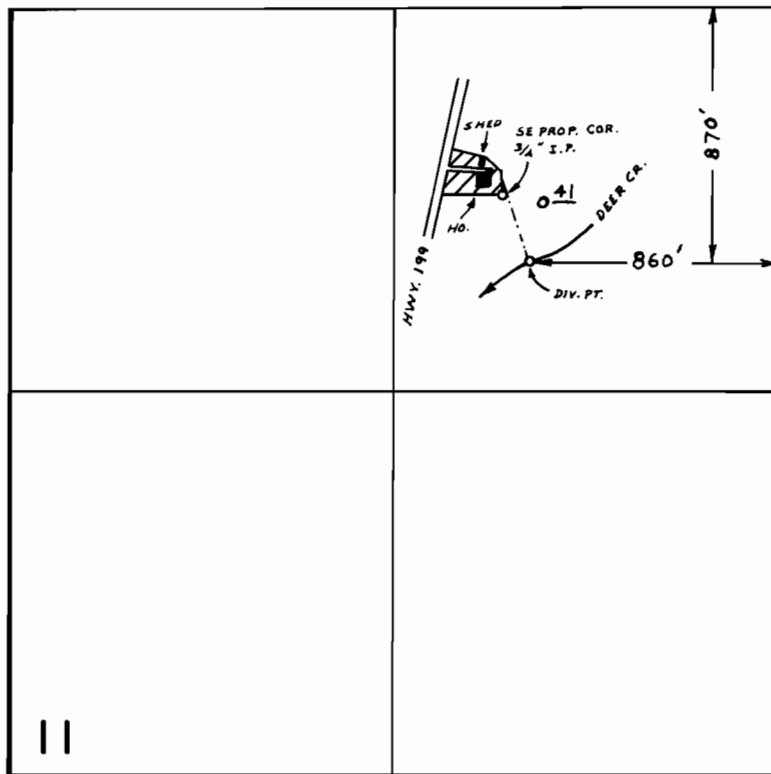

SCALE: 1" = 660 FT.

FINAL PROOF SURVEY
UNDER

Application No. 50424 Permit No. 38055
IN NAME OF

.....
Surveyed JUL. 19 1978, by B. SUND